


Hamilton

KANSAS

Section 36 Township 24 Range 39W

Well No. 2 McDonald

Company ~~W. E. Bakke~~ Jack Villines & Campbell

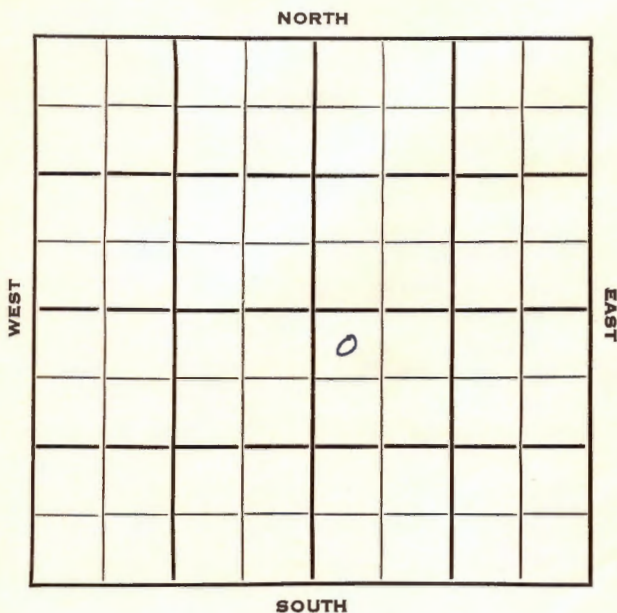

Hamilton

KANSAS


 Sec. 36 Twp. 24 R. 39W

 Well No. #2 McDonald Farm

Jack Villines + Campbell
W. E. Bakke


Company

Contractor

100 Ft. from N. Line

Ft. from S. Line

Ft. from E. Line

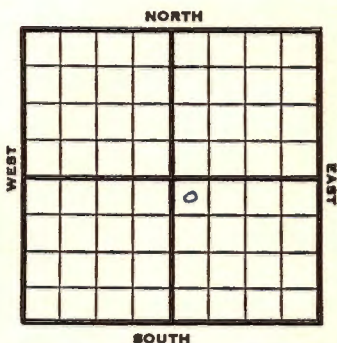100 Ft. from W. Line


NW NW SE

1953 Elev. 3135' REPORT

3/4 8" @ 465

WOC

3/12 RTD 2322

5" @ 2317

3/19 DD 2350 TD

3/26 DD 2531'

4/2 NR

 4/9 Kr 2322, Win 2358, Up Ft. 2436, Low  
Ft. 2472, 2000A

4/16 PB 2273

4/23 CO 2383 4000 A

4/30 N.R.

5/7 NR

5/20 D &amp; A

TD 2531'

8" @ 465'

Kri 2322, Win 2358, Ft. Riley 2436

5" @ 2317'

TD 2350'

DD 2531 2000 A PB 2273

CO to 2383 4000 A

D &amp; A.

ABANDONED

County Hamilton State Kansas  
 Sec. 36 (Blk. 21) (Sur. 39W) Map No. 39W  
 Operator W. E. Bakke  
 Well No. 2 Farm McDonald  
 Elev.          Location NW NW SE

|  |  |  |  |  |  |
|--|--|--|--|--|--|
|  |  |  |  |  |  |
|  |  |  |  |  |  |
100 Ft. From N Line SE  
100 Ft. From W Line Quarter  
 1st. Report MAR 4 1953  
 Completion           
 Remarks           
          
 Spudding Date         

Drig. Data

8" @ 465 WOC

J. G. McGEHEE

County Hamilton State Kansas  
 Sec. 36 (Blk.) 24 (Sur.) 39W Map No.   
 (Twp.) (Rge.)  
 Operator Jack Villines & Campbell  
 Well No. 2 Farm McDonald  
 Elev. 3135 Location NW NW SE

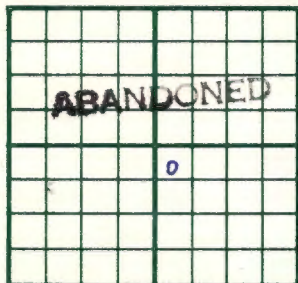

100 Ft. From N Line SE  
100 Ft. From W Line Quarter

1st. Report

Completion MAY 20 1953

Remarks

Spudding Date

Drlg. Data D & A TD 2531  
8" @ 465 Kri. 2322 Win. 2358  
Ft. Riley 2436 5" @ 2317 TD 2350  
DD 2531 2000 A PB 2273 CO to 2383  
4000 A

D & A

J. G. McGEHEE

Map No. \_\_\_\_\_ Sec. 36 Twp. 24 R. 39WWell No. 2 McDonaldJack Villines & Campbell Company**CORRECTION**

Contractor

NW NW SE

## SECTION PLAT

100 Ft. from N. Line

\_\_\_\_\_ Ft. from S. Line

\_\_\_\_\_ Ft. from E. Line

100 Ft. from W. Line

|  |  |   |  |
|--|--|---|--|
|  |  |   |  |
|  |  |   |  |
|  |  | 0 |  |
|  |  |   |  |

Hamilton County

Location \_\_\_\_\_

Rig up \_\_\_\_\_

Drilling and Remarks:

Reported

W. E. Bakke

## RECORD

Cased \_\_\_\_\_ in., \_\_\_\_\_ ft.

Sand \_\_\_\_\_

Gas \_\_\_\_\_

Oil \_\_\_\_\_

Total Depth \_\_\_\_\_

## PRODUCTION

1st 24 hrs. Nat. \_\_\_\_\_

1st 24 hrs. after shot \_\_\_\_\_

Gas \_\_\_\_\_ Cu. Ft.

Dry Hole \_\_\_\_\_

Abandoned \_\_\_\_\_

Date

MAR 25 1953 19

J. G. McGEHEE

Scout