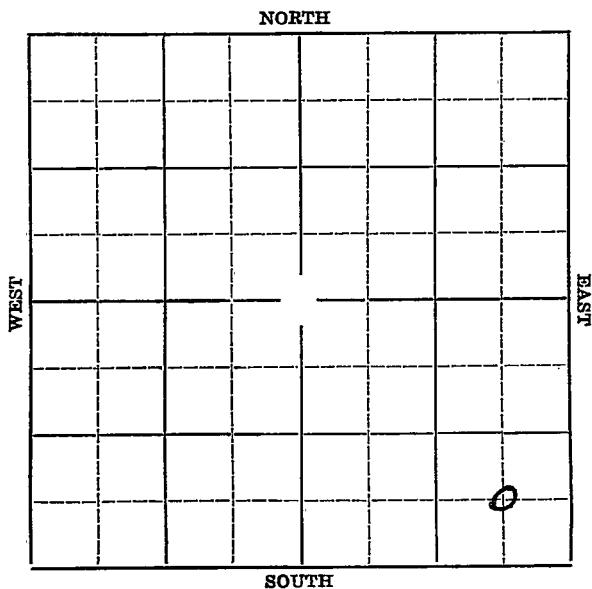


Section 4 Township 24 Range 4-WWell Number 1-Welch "B"Company Shell

Reno

Map No. KANSAS Sec. 4 Twp. 24 R. 4W

Well No. #1 Welch "B" Farm

Shell Company


 Ft. from N. Line

660' Ft. from S. Line

660' Ft. from E. Line

 Ft. from W. Line

Elev. 1472

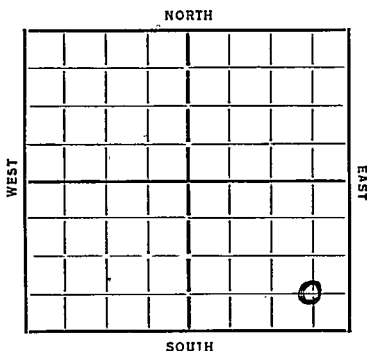

Date 1936 REPORT

5/6 Cellar.

5/14-Rig.

5/21 Drlg. 185'.

5/28 Drlg. 1380'.

6/4 Drlg. 2700'.

6/11 Chat 3279'. Drlg. 3359'.

7/1/36-Chat 3279'.

T.D. 3362'.

2000 gallons of acid.

1279 bbls of oil.

257 bbls of water.

COMPLETED

Map No. 40 Sec. 4 Twp. 24 R. 4W

Well No. 1 Welch "B"

Shell Company

Contractor

SECTION PLAT

Ft. from N. Line

660 Ft. from S. Line

660 Ft. from E. Line

Ft. from W. Line

			0

FIRST REPORT

Location

Rig up

Drilling and Remarks:

Cellar

RECORD

Cased in., ft.

Sand

Gas

Oil

Total Depth

PRODUCTION

1st 24 hrs. Nat.

1st 24 hrs. after shot

Gas Cu. Ft.

Dry Hole

Abandoned

Date

MAY 6 1936

S. J. LEWIS

Scout

KANSAS

Map No. 40 Sec. 4 Twp. 24 R. 4WWell No. 1 1/2 inch BCompany Shell

Contractor _____

SECTION PLAT

			0

_____ Ft. from N. Line

660 Ft. from S. Line660 Ft. from E. Line

_____ Ft. from W. Line

COMPLETED

Location _____

Rig up _____

Drilling and Remarks:

@ ka 3279

2000 acid

1279 oil

2.57 water

RECORD

Cased _____ in., _____ ft.

Sand _____

Gas _____

Oil _____

Total Depth 3262

PRODUCTION

1st 24 hrs. Nat. _____

1st 24 hrs. after shot _____

Gas _____ Cu. Ft.

Dry Hole _____

Abandoned _____

Date

JUL 1 1936

19

S. J. LEWIS

Scout