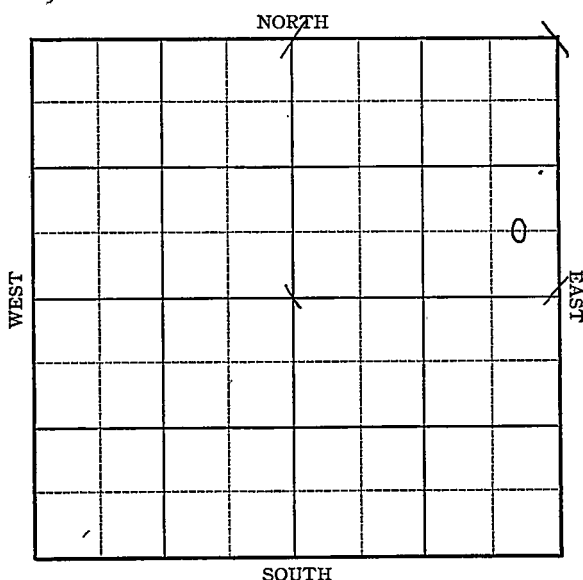


KANSAS

Stafford

FORM 51 5M 1-42 PETROL

Section 4 Township 24 Range 11-WWell No. #1 HagenCompany Magnolia

KANSAS

Stafford

Sec. 4 Twp. 24 R. 11-W

Well No. #1 Hagen Farm

Magnolia Company

Zenith


 Ft. from N. Line

660 Ft. from S. Line

330 Ft. from E. Line

 Ft. from W. Line

Elev. 1814

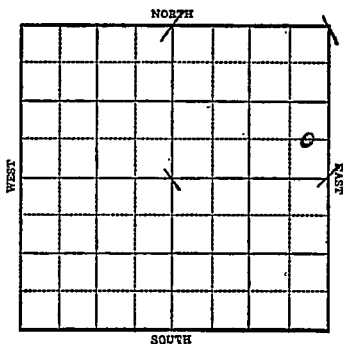

1943

R E P O R T

3/17 Rotary.

3/24 10" @ 266'
Drlg. 2120'

3/31 Drlg. 3100

4/7 Viola 3700 01T.D.
5" @ 3701 RUST.

4/14 T.D. 3729
P.B. 3725 WOC.

4/21 Drlg. 3748' no oil

4/28 Viola 3700
5" @ 3701'
Simp. 3788
T.D. 3855'
No shows.

ABANDONED


KANSAS

Stafford

Map No. 47 Sec. 4 Twp. 24 R. 11WWell No. 1 HagenMagnolia Company**FIRST REPORT** Contractor

C E L S E N E

SECTION PLAT

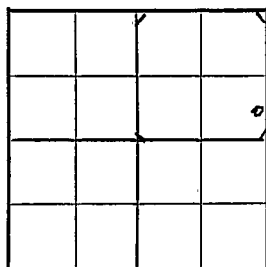 Ft. from N. Line660 Ft. from S. Line330 Ft. from E. Line Ft. from W. Line

ZENITH POOL

Location Rig up

Drilling and Remarks:

Rotary

RECORD

Cased in., ft.Sand Gas Oil Total Depth

PRODUCTION

1st 24 hrs. Nat. 1st 24 hrs. after shot Gas Cu. Ft.Dry Hole Abandoned

Date

MAR 17 1943 19

S. J. LEWIS Scout

KANSAS

Stafford

Map No. 47 Sec. 4 Twp. 24 R. 11WWell No. 1 HagenMagnolia CompanyABANDONED Contractor

C E L S E N E

SECTION PLAT

 Ft. from N. Line660 Ft. from S. Line330 Ft. from E. Line Ft. from W. Line

ZENITH P OOL

Location Rig up

Drilling and Remarks:

*Vida 3700**5" @ 3701**Stop 3788**Wash hole*

RECORD

Cased in., ft.Sand Gas Oil Total Depth 3700

PRODUCTION

1st 24 hrs. Nat: 1st 24 hrs. after shot Gas Cu. Ft.Dry Hole Abandoned

Date

APR 28 1943 19 S. J. LEWIS Scout