


Section 4 Township 24 Range 12-W

Well No. 1 Hitz

Company Nelson Drilling et al

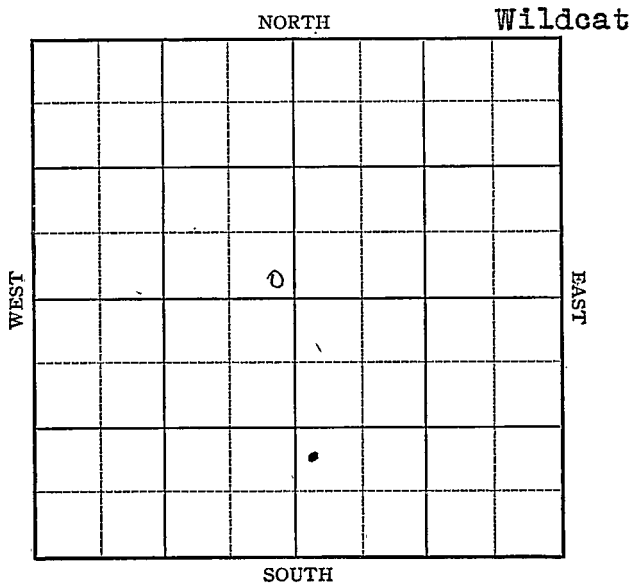

Sec. 4 Twp. 24 R. 12-W

Well No. #1 Hitz Farm

Nelson Drlg. et al Company


(Wildcat) Q

_____ Ft. from N. Line

330 Ft. from S. Line

330 Ft. from E. Line

_____ Ft. from W. Line

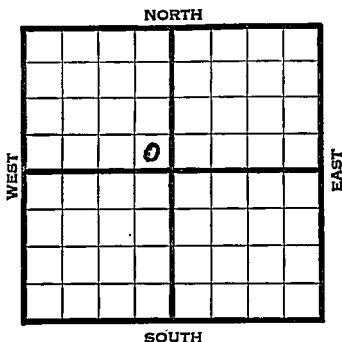

Elev. 1884

1941	REPORT
9/17	Derrick.
9/25	10" - 219' Anhy 675'
	Drlg. 2592'
10/2	Lans. 3473' Viola 3801'
	Coring 3867½'
10/9	Arb. 3998' 5" - 3850'
	T.D. 4032' P.B. to 3880'
10/16	" " " "
10/23	P.B. to 3840'
	30 shots 3800-14' 1000 acid.
	Estimated 10 M gas.
	Shut down.
10/30	" "

OVER

1941
11/5

Viola 3800'
Arb. 3998'
7" - 3850'
T.D. 4032'
P.B. to 3840'
40 shots 3800-14'
1000 acid.
6,399,000 cu. ft. gas.

COMPLETED

Map No. 47 Sec. 4 Twp. 24 R. 12WWell No. 1 HitzNelson Drilling et al CompanyFIRST REPORT Contractor

SE NW

SECTION PLAT

 Ft. from N. Line330 Ft. from S. Line330 Ft. from E. Line Ft. from W. Line

WILDCAT

Location Rig up

Drilling and Remarks:

Derrick

RECORD

Cased in., ft.Sand Gas Oil Total Depth

PRODUCTION

1st 24 hrs. Nat. 1st 24 hrs. after shot Gas Cu. Ft.Dry Hole Abandoned

Date

SEP 17 1941 19S. J. LEWIS Scout

Map No. 7-47 Sec. 4 Twp. 24 R. 12W

Well No. 1 Hitz

Nelson Drilling etal Company

COMPLETED

Contractor

SE NW

SECTION PLAT

_____ Ft. from N. Line

330 Ft. from S. Line

330 Ft. from E. Line

_____ Ft. from W. Line

WILDCAT

RECORD

Location _____

Cased _____ in., _____ ft.

Rig up _____

Sand _____

Drilling and Remarks:

Gas _____

Oil _____

Total Depth 4032

*Viola 3500
 Co X 3998
 7" Co 3850
 PB 3840
 40 shot to 3500-14.
 1000 acid*

PRODUCTION

1st 24 hrs. Nat. _____

1st 24 hrs. after shot _____

Gas _____ Cu. Ft.

Dry Hole _____

Abandoned _____

6.399000 cu ft

gas.

Date

NOV 5 1941 19

S. J. LEWIS Scout