

Section 4 Township 24 Range 12 WWell No. # 1 Kelley (B)Company Cities Service Oil

NORTH

WEST

EAST

SOUTH

Stafford

KANSAS

Sec. 4 Twp. 24 R. 12W

Well No. #1 Kelly (B) Farm

Cities Service Oil Company

Rine Contractor


990 Ft. from N. Line

 Ft. from S. Line

 Ft. from E. Line

990 Ft. from W. Line

SE NW SW

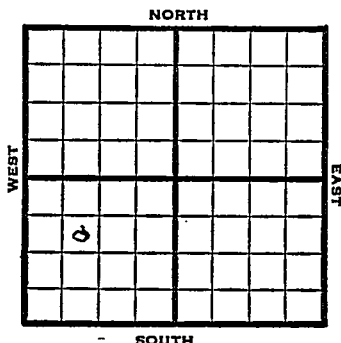

1952

Elev. 1879'

REPORT

3/12

Spud 3-8-52
8" @ 250' WOC

3/19

Br Li 3435 Lans. 3460
V. 3797
Drlg. 3872'

3/25

Simp. 3930' RTD 3945' 5" @ 3945'
RUST

4/1

CO to 3925' 48/3820-30 500 A
2,900,000 Set plug 3817'
56/3795-3809 1000 A Sho gas.
CO to 3925' gas

4/9

4,400,000 gas thru 2" tubing

4/23

NR

4/30

NR

5/7

NR

5/14

"

5/21

"

5/28

"

6/11

Spud 3-8-52 Gas Well TD 3945
8" @ 250 Br Li 3435 Lans. 3460
Viola 3797 Simp. 3930
TD 3945 5" @ 3945' CO to 3925
48/3820-30 500 A 2,900,000 gas
SP 3817 56/3795-3809 1000 A
SG CO to 3925' Comp. 4,400,000 gas


COMPLETED

County Stafford State Kansas
 Sec. 4 (Blk. 24 (Sur. 12W Map No.
 (Twp.) (Rge.)

Operator Cities Service Oil

Well No. 1 Farm Kelley (B)

Elev. Location SE NW SW

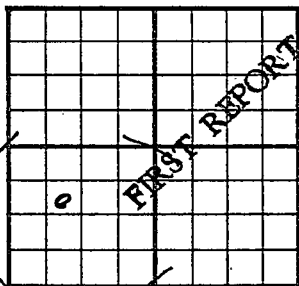

990 Ft. From N Line SW

990 Ft. From W Line Quarter

1st. Report MAR 1 2 1952

Completion

Remarks


Rine - Contr.

Spudding Date 3-8-52

Drlg. Data

8" @ 250 W.O.C.

J. G. McGEHEE

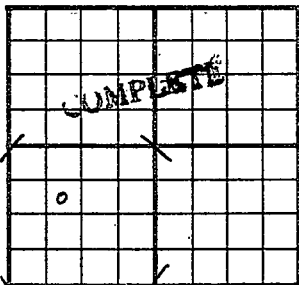County Stafford State KansasSec. 4 (Blk. Twp.) 24 (Sur. Rge.) 12W Map No.Operator Cities ServiceWell No. 1 Farm Kelley "B"Elev. 1879 Location SE NW SW

990 Ft. From N Line SW

990 Ft. From W Line Quarter

1st. Report

Completion JUN 11 1952

Remarks

Rine Drlg. - Contr.Spudding Date 3-8-52Drlg. Data Gas well TD 39458" @ 250 Br. lime 3435 Lans. 3460Viola 3797 Simp. 3930 TD 39455" @ 3945 CO to 3925 48/ 3820-30500 A 2,900,000 gas SP 381756/ 3795-3809 1000 A SG CO to 3925Comp. 4,400,000 gas

J. G. McGEHEE