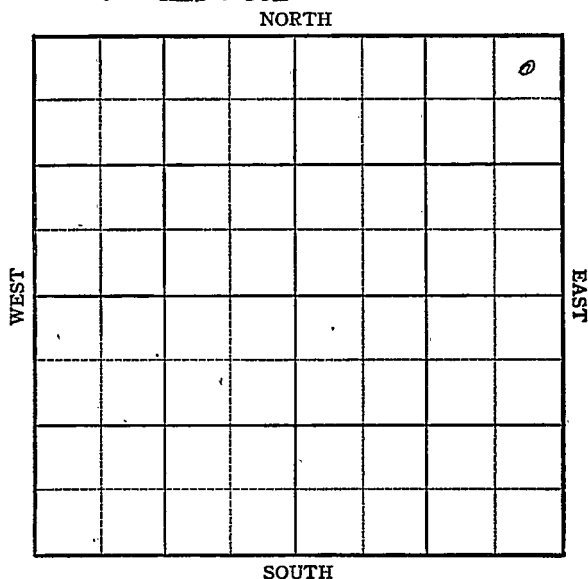


Stafford
KANSASSection 4 Township 24 Range 13-WWell No. #1 GlasscockCompany Crown Oil
St Johns Pool

Stafford

KANSAS

13W

Sec. 4 Twp. 24 R. 13W

Well No. #1 Glasscock Farm

Crown Oil

Company

St. Johns Pool

NORTH


330' Ft. from N. Line

 Ft. from S. Line

330' Ft. from E. Line

 Ft. from W. Line

NE/C

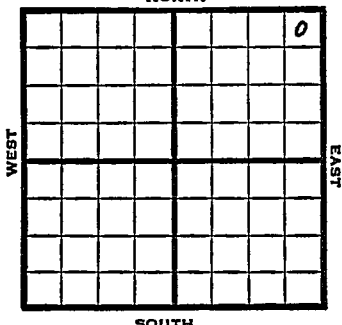

SOUTH

1949 Elev. 1908' REPORT

11/23 Location

11/29 8" @ 231'

Drlg 1980'

12/7 Lansing 3520'

Drlg 3625'

12/14 Arbuckle 3937'

TD 3940'

5" @ 3938'

12/21 "

12/28 "

1950

1/25 8" @ 231'

5" @ 3938'

Lans 3520'

Arb 3934'

P 60 BOPD

TD 3938'

COMPLETED

Map No. _____ Sec. 4 Twp. 24 R. 13W

Well No. 1 Glasscock

Crown Oil Company

Contractor _____

NE/c

FIRST REPORT
SECTION FLAT

330 Ft. from N. Line

_____ Ft. from S. Line

330 Ft. from E. Line

_____ Ft. from W. Line

			o

Stafford County

Location X

Rig up _____

Drilling and Remarks:

RECORD

Cased _____ in., _____ ft.

Sand _____

Gas _____

Oil _____

Total Depth _____

PRODUCTION

1st 24 hrs. Nat. _____

1st 24 hrs. after shot _____

Gas _____ Cu. Ft.

Dry Hole _____

Abandoned _____

Date

NOV 23 1949 19

S. J. LEWIS

Scout


Kansas

St. Johns

Map No. _____ Sec. 4 Twp. 24 R. 13WWell No. 1 GlasscockCrown Oil

Company

Contractor

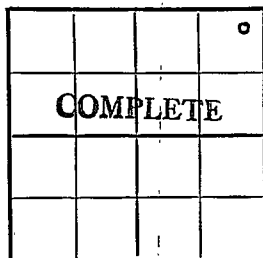NE/CEI 1908
SECTION PLAT330 Ft. from N. Line Ft. from S. Line330 ⁴³
290 Ft. from E. Line Ft. from W. LineStafford County

Location _____

Rig up _____

Drilling and Remarks:

8" @ 2315" @ 3938Lans 3520and 3934P 60 BOPDd

RECORD

Cased _____ in., _____ ft.

Sand _____

Gas _____

Oil _____

Total Depth 3938

PRODUCTION

1st 24 hrs. Nat. _____

1st 24 hrs. after shot _____

Gas _____ Cu. Ft.

Dry Hole _____

Abandoned _____

Date

JAN 25 194019J. E. TYRA Scout