

Section 4 Township 24 Range 14-WWell No. #1 SutorCompany Lindas Oil

NORTH							
							0
SOUTH							

WEST EAST

Stafford

Sec. 4 Twp. 24 R. 14W ✓

Well No. #1 Sutor Farm

Lindas Oil Company

Wildcat Contractor

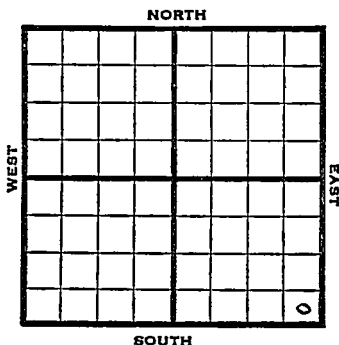
 Ft. from N. Line

330' Ft. from S. Line

330' Ft. from E. Line

 Ft. from W. Line

SE SE SE



1950

Elev 1963'

R E P O R T

12/27

RUR

1951

1/17

Spud 12-27-50

8" @ 215

Anhy 890

Heeb 3476

Br line 3616

Lans 3637

DST 3760-71 opn 1 hr rec 25' mud

Cong 3987

Viola 3999

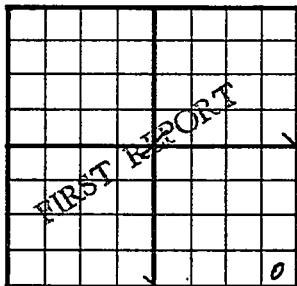
DST 3989-4023 opn 40 min rec 40' mud

Arb 4225

TD 4300

D&A

ABANDONED

County Stafford State KansasSec. 4 (Blk.) 24 (Sur.) 14W Map No.Operator Lindas OilWell No. 1 Farm SutorElev. Location SE SE SE330 Ft. From S Line SE330 Ft. From E Line Quarter1st. Report DEC 27 1960

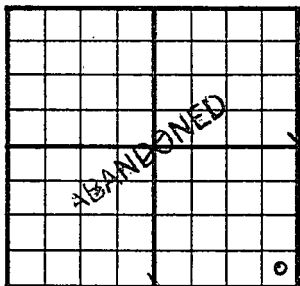
Completion

Remarks

Spudding Date

Drig. Data WildcatRUR

J. E. TYRA

County Stafford State KansasSec. 4 (Blk.
Twp.) 24 (Sur.
Rge.) 14W Map No.Operator Lindas OilWell No. 1 Farm SutorElev. 1963 Location SE SE SE330 Ft. From S Line SE330 Ft. From E Line Quarter

1st. Report

Completion JAN 17 1951Remarks WildcatSpudding Date 12-27-50Drlg. Data D & A TD 43008" @ 215 Anhy 890 Heeb. 3476Br. lime 3616 Lans. 3637 DST 3760-71open 1 hr. Rec. 25' mud Cong. 3987 VViola 3999 DST 3989-4023 open 40 min.Rec. 40' mud Arb. 4225 TD 4300D & A

J. E. TYRA