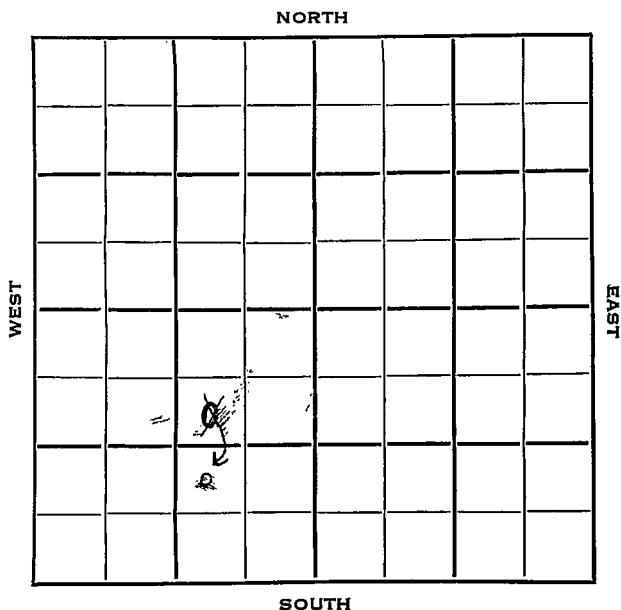


Section 4 Township 24 Range 16 WWell No. # 1 HahnCompany Natural Gas & Oil

Edwards KANSAS

SEC. 4	TWP. 24	R. 16 W
--------	---------	---------

WELL NO.

1 Hahn

FARM

COMPANY

Natural Gas & Oil

CONTRACTOR

Natural Gas & Oil


~~990~~ Ft. from N. Line

990 Ft. from S. Line

990 Ft. from E. Line

Ft. from W. Line

NW SE SW
SW NE SW

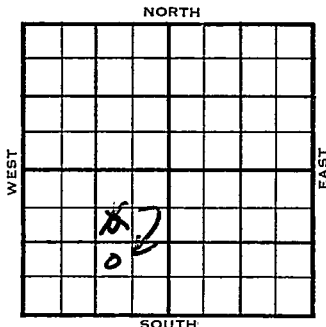

1953

ELEVATION

2079'

REPORT

11/18

MIR

12/30

Spud 11-18-53

Oil Well

TD 4493'

10" @

Anhy 1031', KC 3737', B KC 3995'

DST 4130-50'

DST 3729-48', opn 3/4 hrs., rec. 40' mud, 710#

DST 3750-77', opn 1 hr., rec. 80'

soem, 60' hocgm, 180' mco, 1190#

DST 3779-95', opn 1 hr., rec. 115'

15' mud, 1250#

Miss 4145'

DST 4114-50', opn 1 hr., gas to surface in 15 mins., 30' gcm, 1000#

Viola 4138', Simp 4349'

DST 4253-68', opn 1 hr., rec. 8' mud, Arb. 4381'

DST 4384-93', opn 1 hr., rec. 1800' sw 1440#

TD 4493'

5 1/2" @ 3851',

CO to 3776'

32/3770-74, S/5 to 6 gwph 5 hrs.

200A, 1000A

Comp. 284 bopd

J. G. McGEHEE

Kansas

Map No. _____ Sec. 4 Twp. 24 R. 16WWell No. 1 Hahn

Natural Gas & Oil _____ Company

CORRECTION _____ Contractor


NW SE SW

SECTION PLAT

_____ Ft. from N. Line

990 Ft. from S. Line990 Ft. from E. Line

_____ Ft. from W. Line

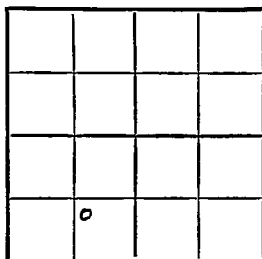Edwards County

Location _____

Rig up _____

Drilling and Remarks:

Reported

SW NE SW

RECORD

Cased _____ in., _____ ft.

Sand _____

Gas _____

Oil _____

Total Depth _____

PRODUCTION

1st 24 hrs. Nat. _____

1st 24 hrs. after shot _____

Gas _____ Cu. Ft.

Dry Hole _____

Abandoned _____

Date

DEC 2 1953 19J. G. McGEHEE Scout

J. G. McGEHEE