

Edwards.

DX 78-1


KANSAS

Section 4 Township 24 Range 16W

Well No. #3 Hahn

Company Natural Gas & Oil

NORTH

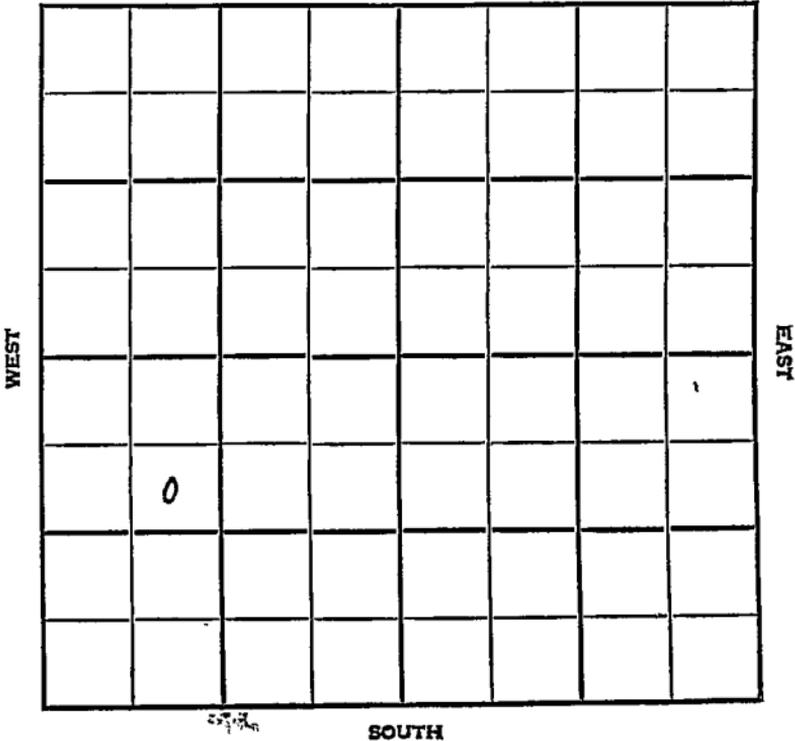

SEC.	TWP.	R.
4	24	16W

WELL NO. #3 Hahn FARM

COMPANY Natural Gas & Oil

CONTRACTOR G-M-R


Enlow Pool

990 Ft. from N. Line

Ft. from S. Line

Ft. from E. Line

990 Ft. from W. Line

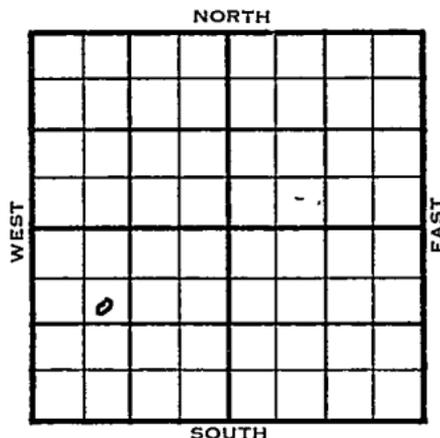

SE NW SW

1955	ELEVATION 2077'	REPORT
------	-----------------	--------

3/9 Spud 3-2-55  
10" @ 208'  
Dr1g. 3600'

4/6 Spud 3-2-55  
Oil Well  
TD 3820'  
10" @ 208'  
Heeb. 3584', Br. Lime. 3710'  
Lans. 3719'  
DST 3746'-60' opn 1 hr, gas in 8 min  
rec 1980' gco  
TD 3820'  
7" @ 3801'  
CO to 3766  
32/ 3753-56  
1 boph 500 A 30 boph 4 hr.  
Comp 412 bopd.

COMPLETED



