


Section 5 Township 24 Range 10-W


Well No. 4 Paine

Company Shell

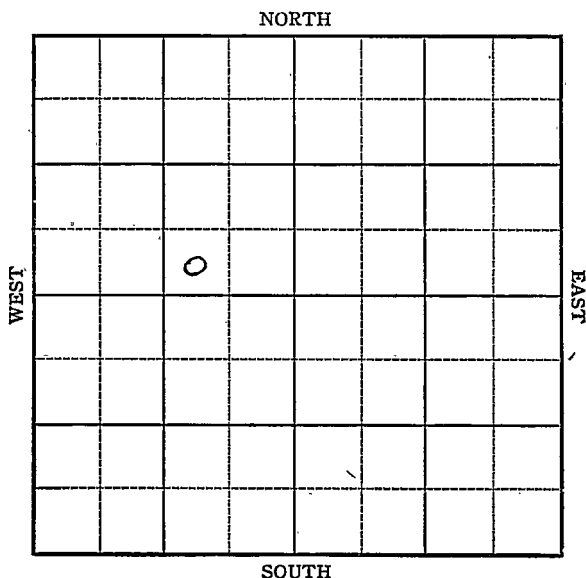

Sec. 5 Twp. 24 R. 10-WWell No. #4 Paine FarmShell Company

NORTH

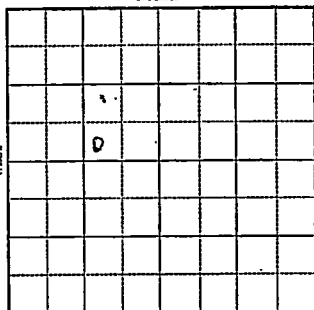

SOUTH

 Ft. from N. Line330 Ft. from S. Line990 Ft. from E. Line Ft. from W. LineElev. 1783

1943

R E P O R T

11/3 Rotary

11/10 8" @ 320

Drilg. 2145

11/17 Topeka 2826

Drilg. 3057'

11/24 Viola 3748-56 TD

4" @ 3149

RUST

12/1 TD 3756 50 acid

12/8 TD 3788 flow 100 oil in 5 hrs.

4-3/10 M gas.

12/15 4" @ 3749

Viola 3748

500 acid

Flow 356 oil 2,077,000 gas

TD 3788

Grav. 42

COMPLETED

KANSAS
Map No. 48 Sec. 5 Twp. 24 R. 10W
Well No. 4 Paine

Shell Company

FIRST REPORT Contractor

SW SE NW

SECTION PLAT

 Ft. from N. Line

330 Ft. from S. Line

990 Ft. from E. Line

 Ft. from W. Line

	o		

Zenith Pool

Location

Rig up

Drilling and Remarks:

Rotary

RECORD

Cased in., ft.

Sand

Gas

Oil

Total Depth

PRODUCTION

1st 24 hrs. Nat.

1st 24 hrs. after shot

Gas Cu. Ft.

Dry Hole

Abandoned

Date

NOV 3 1943 19 S. J. LEWIS Scout

Reno

KANSAS
Map No. 47 Sec. 5 Twp. 24 R. 10W


Well No. 4 Paine

Shell Company

COMPLETED Contractor

SW SE NW

SECTION PLAT

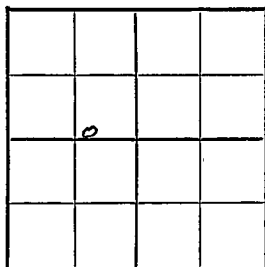

_____ Ft. from N. Line

330 Ft. from S. Line

990 Ft. from E. Line

_____ Ft. from W. Line

Zenith Pool

Location _____

Rig up _____

Drilling and Remarks:

Viola 3748

4" @ 3748

500 acid

Flow 356 oil

2,077,000 gas

422 gr

RECORD

Cased _____ in., _____ ft.

Sand _____

Gas _____

Oil _____

Total Depth 3788

PRODUCTION

1st 24 hrs. Nat. _____

1st 24 hrs. after shot _____

Gas _____ Cu. Ft.

Dry Hole _____

Abandoned _____

Date

DEC 15 1943 19

S. J. LEWIS Scout