

Section 5 Township 24 Range 13W

Well No. 1 Hoover

Company Cities Service

Wildcat

NORTH

	0						

WEST

EAST

SOUTH

KANSAS

Stafford

13W

Sec. 5 Twp. 24 R. 13W

Well No. #1 Hoover Farm

Cities Service Company

Wildcat


330' Ft. from N. Line

_____ Ft. from S. Line

_____ Ft. from E. Line

330' Ft. from W. Line

NW/C

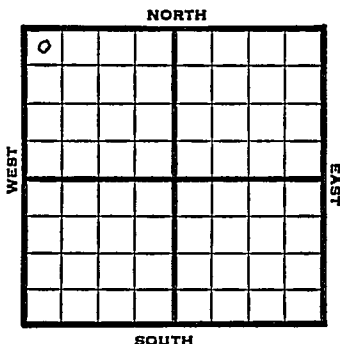

1949 Elev 1915' REPORT

2/2 RUR

2/9 8" @ 291'

Drlg. 1945'

2/16 Lansing 3548'

Drlg. 3600'

2/23 Viola 3923'

Simpson 4014'

Simpson 4029'

Arbuckle 4053'

TD 4080'

PB 4063

5" @ 4030'

3/2 " "

3/8 " "

3/16 PB 4045'

15 qts CO

3/23 PB 3790'

36 shots 3666-80

3000 acid

Swb 175 bbls oil 14 hrs.

3/30 21 shots 3680-85 - 5000 acid

Flow 180 bbls oil 8 hrs

4/6 " "

4/13 TD 4080'

Lans. 3548'

Arb. 4063'

5" @ 4030'

Perf Lans.

8000 acid

Flow 432 Oil / 6 W Pot 40° gr. comp

COMPLETED

Map No. _____ Sec. 5 Twp. 24 R. 13W

Well No. 1 Hoover

_____ Cities Service _____ Company

FIRST REPORT

_____ Contractor

NW /C


SECTION PLAT

330 Ft. from N. Line

_____ Ft. from S. Line

_____ Ft. from E. Line

330 Ft. from W. Line

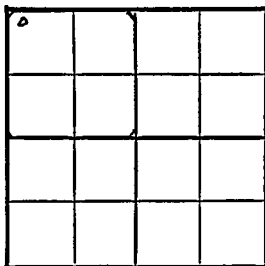

. Stafford County

RECORD

Location _____

Cased _____ in., _____ ft.

Rig up _____

Sand _____

Drilling and Remarks:

Gas _____

Oil _____

R U R

Total Depth _____

PRODUCTION

1st 24 hrs. Nat. _____

1st 24 hrs. after shot _____

Gas _____ Cu. Ft.

Dry Hole _____

Abandoned _____

Date

FEB 2 1949 19

S. J. LEWIS

Scout

Kansas

Map No. 83 Sec. 5 Twp. 24 R. 13W

Well No. 1 Hoover

Cities Service Company

COMPLETE

Contractor

NW/C

E11915
SECTION PLAT

330 Ft. from N. Line

 Ft. from S. Line

1 Ft. from E. Line

330 Ft. from W. Line

0			

Stafford County

Location _____

Rig up _____

Drilling and Remarks:

Ham 3545

Art 4063

5" @ 4030

*Pay Ham
8000 and C*

*Flow 4820 ft + 6W
R.F.*

RECORD

Cased _____ in., _____ ft.

Sand _____

Gas _____

Oil _____

Total Depth 4050

PRODUCTION

1st 24 hrs. Nat. _____

1st 24 hrs. after shot _____

Gas _____ Cu. Ft.

Dry Hole _____

Abandoned _____

Date

40th Dec

APR 13 1949

19

S. J. LEWIS

Scout