

KANSAS


Hodgeman County

FORM 51 5M BR1X

Section 5 Township 24 - Range 21W

Well No. 1 T. Gleason

Company Continental

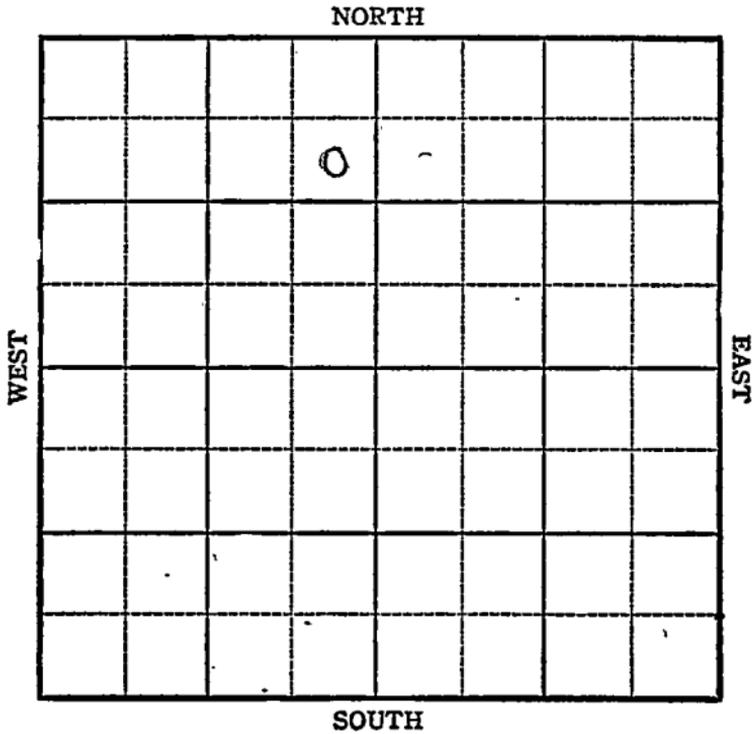

KANSAS

Hodgeman

Sec. 5 Twp. 24 R. 21W

Well No. #1 T Gleanson Farm


Continental Company

Wildcat
990' Ft. from N. Line

 Ft. from S. Line

330' Ft. from E. Line

 Ft. from W. Line

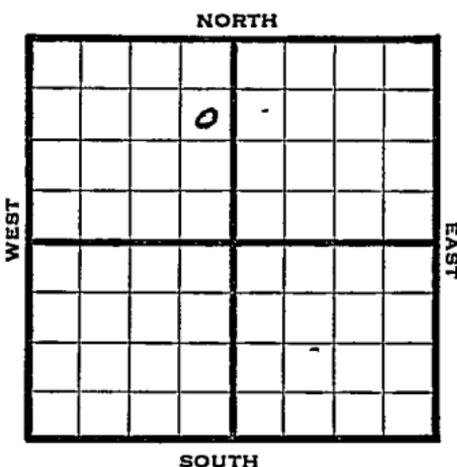

1944

REPORT

6/28	Derrick
7/12	2643 fishing
7/19	3540 fishing
7/26	" "
8/2	TD 3540 Lost hole skid rig 100' east
8/9	16" @ 127 Drlg. 1240
8/16	10" @ 1480 Drlg. 2915
8/23	Drlg. 4045
8/30	Topeka 3658 Lans 4096 Drlg. 4662
9/8	Topeka 3616 corrected Lans 4024 Miss 4633 Drlg. 4969
9/13	Simp. 4950 Arb. 4971 TD 5085 No show 7" @ 4748' RUST
9/21	60 shots 4631-90 VSSO plus 1000' wtr in 3 hrs.
9/28	" " " " " " "
10/4	" " " " " " "
10/11	Arb. 4971' 7" @ 4748' TD 5085' Water

ABANDONED


Pool Name WildcatMap No. KANSAS Sec. 5 Twp. 24 R. 21WWell No. 1 T. GleansonContinental Company

FIRST REPORT

Contractor

SE NE NW

SECTION PLAT

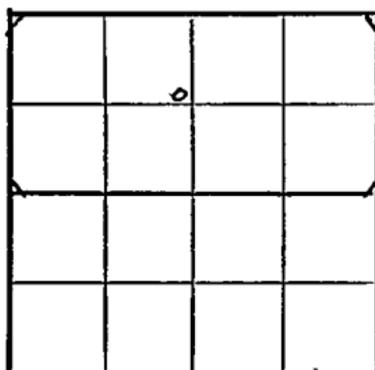990 Ft. from N. Line Ft. from S. Line330 Ft. from E. Line Ft. from W. LineHodgeman CountyLocation Rig up

Drilling and Remarks:

Derrick

RECORD

Cased in., ft.Sand Gas Oil Total Depth

PRODUCTION

1st 24 hrs. Nat. 1st 24 hrs. after shot Gas Cu. Ft.Dry Hole Abandoned

Date

JUN 28 1944 19S. J. LEWIS Scout

Pool Name WildcatMap No. 95 Sec. 5 Twp. 24 R. 21WWell No. 1 T . GleansonContinental


Company

ABANDONED

Contractor

SE NE NW

SECTION PLAT

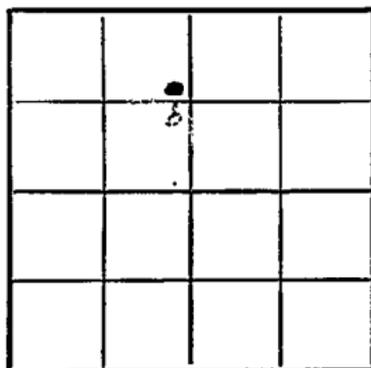990 Ft. from N. Line

Ft. from S. Line

330 Ft. from E. Line

Ft. from W. Line

Hodgeman County

RECORD

Location _____

Cased _____ in., _____ ft.

Rig up _____

Sand _____

Drilling and Remarks:

Gas _____

Oil _____

Total Depth 575Ord 49717" @ 4748Water.

PRODUCTION

1st 24 hrs. Nat. _____

1st 24 hrs. after shot _____

Gas _____ Cu. Ft.

Dry Hole _____

Abandoned* _____

Date

OCT 1 1 1944 19S. J. LEWIS Scout