


Finney

KANSAS

SECTION 5 TOWNSHIP 24 RANGE 32 W

WELL NO. #1 Baldwin Gas Unit

COMPANY Stanolind

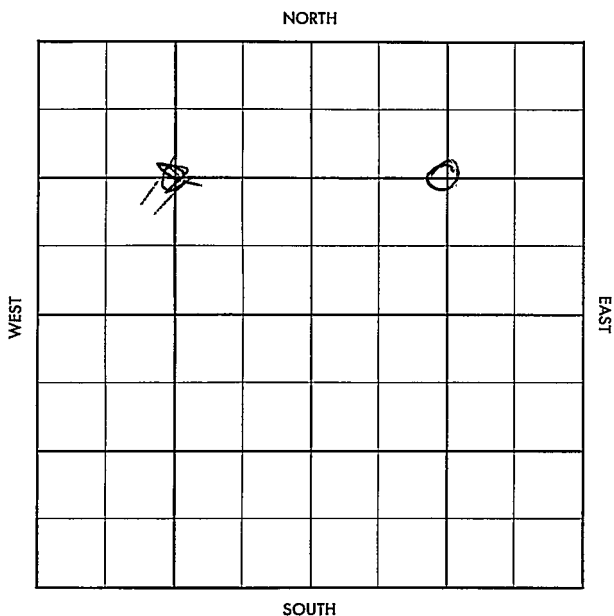

Finney

KANSAS

SEC. 5	TWP. 24	R. 32W
-----------	------------	-----------

WELL NO.

#1 Baldwin Gas Unit

FARM

COMPANY

Stanolind

CONTRACTOR

Noble

HUGOTON


Ft. from N. Line

Ft. from S. Line

Ft. from E. Line

Ft. from W. Line

C NE/4

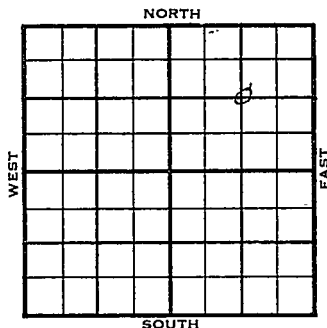

1955

ELEVATION

2865 RB, 2862 DF

REPORT

11-30

Location

12-21

Comm. 11-28-55

8 5/8" @ 977/600

5 1/2" @ 2625/1000

CO to 2613, 40/ 2598-2608, frac

876 mcfg, PB 2581, 72/ 2538-56

56/ 2564-78, frac,

CO to 2313, 1,104 mcfg.

Comp. F/ 2,892 mcfgpd, 361#

Herr. 2538

Kri. 2566

Wfd, 2598

TD 2626'

COMPLETED

County

~~Finney~~

Elev.

2865 RB

2862 DF

Sec.

5

Twp.

24

Rge.

32W

Company

~~Stanplind~~

FarmName

~~Baldwin Gas Unit~~

No.

1

TOPS

DEPTH

LOG

DATUM

Loc. in Sec.

Anb.

Tp.

H.

Tr.

Dg.

Bl.

L.

K.C.

B.K.C.

Ce.

C.

M.

M.

K.

Mz.

Me.

V.

S.

S.

A.

R.

Pe.

G.

T.D.

C NE/4

1390' NL

Geol.

Contr.

Noble

Pool

Hugoton

RGV 30 '55

FIRST REPORT

Date Comm.

Location

Co.

Lse.

T. No.

Sec.

T.

R.

2865 RB

County Finney

Elev. 2862 DF

Sec. 5 Twp. 24Rge. 32WCompany StanolindFarm Name Baldwin Gas Unit No. 1

TOPS	DEPTH	LOG	DATUM	Loc. in Sec.
Anh. <u>Hetr</u>	<u>2538</u>			<u>C NE/4</u>
T.P. <u>XHI</u>	<u>2566</u>			
H. <u>Wfd</u>	<u>2598</u>			<u>1390' NL</u>
Tr.				
Dg.				
BL.				
L.				Geol.
K.C.				
B.K.C.				Contr.
Ce.				<u>Noble</u>
C.				
M.				Pool
M.				<u>Hugoton</u>
K.				
Mz.				
Mo.				
V.				
S.				
S.				
A.				
R.				
Pe.				
G.				
T.D.	<u>2626</u>			

COMPLETE

Date Comm. 11-28-55

DEC 21 1955

8 5/8" @ 977/600 5 1/2" @ 2625/1000CO to 2613 40/ 2598-2608 frac876 mcfg PB 2581 72/ 2538-5656/ 2564-78 frac CO to 23131,104 mcfg Comp. F/ 2,892 mcfgpd 361#