


Finney

Section 5 Township 24 Range 34W

Well No. #1 Garnand

Company Champlin Ref.

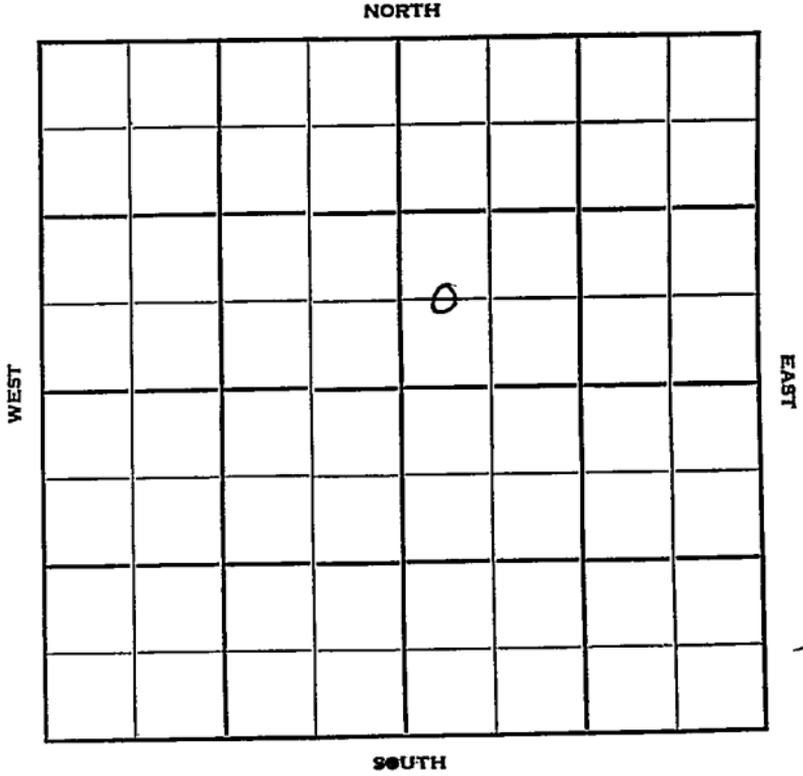

Finney

KANSAS

Sec. 5 Twp. 24 R. 34W

Well No. #1 Garnand Farm

Champlin Ref. Company

Hugoton Pool Contractor

Ft. from N. Line

660'


Ft. from S. Line

Ft. from E. Line

330'

Ft. from W. Line

C W L SW NE

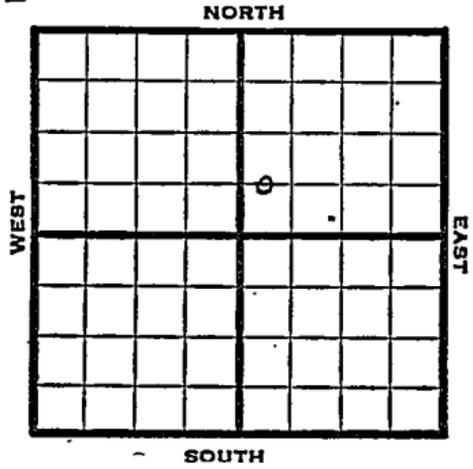

1950

Elev. 2931 REPORT

12/6

Location

1951
2/7

Spud 12/9/50
Gas well TD 2580
10" @548
Hol. 2380 Her. 2394 Krider 2420
Win. 2480 Towanda 2540
TD 2580
7" @2579 90/ 2540-55 90/ 2483-98
264/ 2420-64 24/ 2394-98 30/ 2380-85
38500 A
Comp. 4, 282,000 gas
COMPLETED

County Finney State Kansas

Sec. 5 (Blk. 24) (Sur. 34W) Map No.

Operator Champlin Ref.

Well No. 1 Farm Garnand

Elev. 2931 Location C W L SW NE

660 Ft. From S Line NE

330 Ft. From W Line Quarter

Ist. Report

Completion FEB 7 1951

Remarks Hugoton Pool

Spudding Date 12-9-50

COMPLETE

Drlg. Data Gas well TD 2580

10" @ 548 Hol. 2380 Her. 2394

Krider 2420 Win. 2480 Towanda 2540

TD 2580 7" @ 2579 90/ 2540-55

90/ 2483-98 264/ 2420-64 24/ 2394-98

30/ 2380-85 38500 A Comp. 4,282,000 gas

J. E. TYRA