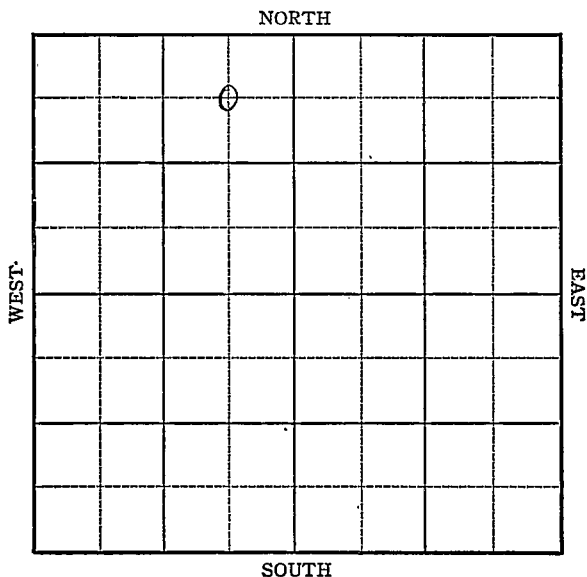


KANSAS

Reno

FORM 51 5M 10-41 PETROL

Section 6 Township 24 Range 10-WWell No. #4 DarrCompany Magnolia

KANSAS


Reno

Sec. 6 Twp. 24 R. 10-WWell No. #4 Darr FarmMagnolia Company

Zenith

660 Ft. from N. Line         Ft. from S. Line660 Ft. from E. Line         Ft. from W. Line

Elev. 1806

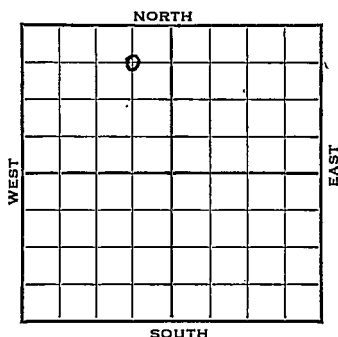

1943

## REPORT

3/3 10" Casing set 277' WOC.

3/10 Drlg. 2720'

3/17 Misiner 3691  
Viola 3695-96 T. D.  
5" Casing set 3696 RUST.

3/24 Pay 3721-22 T.D.  
2000 acid, flow 24 bbls oil per  
hr for 7 hrs.  $\frac{1}{4}$ " choke.

3/31 Viola 3695  
5" @ 3696  
Bomb Pot 3327  
Max 3000  
Gr. 42  
T.D. 3722'

**COMPLETED**

Reno

KANSAS

Map No. 8/7 Sec. 6 Twp. 24 R. 10WWell No. 4 DarrMagnolia

Company

## FIRST REPORT

Contractor

C NE NW

660 Ft. from N. Line         Ft. from S. Line660 Ft. from E. Line         Ft. from W. Line

## SECTION PLAT

|  |   |  |  |
|--|---|--|--|
|  | o |  |  |
|  |   |  |  |
|  |   |  |  |
|  |   |  |  |

## ZENITH POOL

Location         Rig up         Drilling and Remarks:         

10"-2771

W. O. C.

## RECORD

Cased          in.,          ft.Sand         Gas         Oil         Total Depth         

## PRODUCTION

1st 24 hrs. Nat.         1st 24 hrs. after shot         Gas          Cu. Ft.Dry Hole         Abandoned         

Date

MAR 3 1943

19

S. J. LEWIS Scout

Reno

KANSAS

Map No. 47 Sec. 6 Twp. 24 R. 10WWell No. 4 DarrMagnolia

Company

COMPLETED

Contractor

C NE NW

SECTION PLAT

660

Ft. from N. Line

Ft. from S. Line

660

Ft. from E. Line

Ft. from W. Line

|  |   |  |  |
|--|---|--|--|
|  | 0 |  |  |
|  |   |  |  |
|  |   |  |  |
|  |   |  |  |

ZENITH POOL

Location

Rig up

Drilling and Remarks:

Vidla 36955" @ 3696Bone & Pot 3327Max 300042 @ 32

RECORD

Cased \_\_\_\_\_ in., \_\_\_\_\_ ft.

Sand \_\_\_\_\_

Gas \_\_\_\_\_

Oil \_\_\_\_\_

Total Depth 3222

PRODUCTION

1st 24 hrs. Nat. \_\_\_\_\_

1st 24 hrs. after shot \_\_\_\_\_

Gas \_\_\_\_\_ Cu. Ft.

Dry Hole \_\_\_\_\_

Abandoned \_\_\_\_\_

Date

MAR 3 1 1943

19

S. L. LEWIS

Scout