

KANSAS


Reno

FORM 51 5M 1-42 PETROL

Section 6 Township 24 Range 10-W

Well No. #4 Johnson

Company Skelly

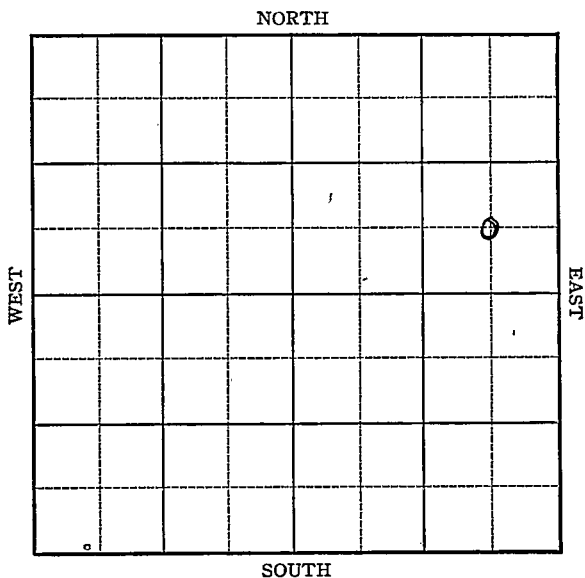

KANSAS

Reno

Sec. 6 Twp. 24 R. 10-W

Well No. #4 Johnson Farm

Skelly Company


Zenith

 Ft. from N. Line

660 Ft. from S. Line

660 Ft. from E. Line

 Ft. from W. Line

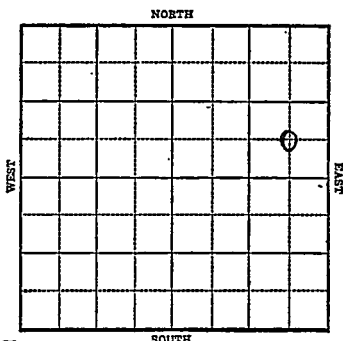

Elev. 1797

1943

R E P O R T

6/9	Location.
6/16	10" @ 280' WOC.
6/23	Drlg. 1600'
6/30	Drlg. 3240'
7/7	Ans 3303 Drlg. 3667'
7/15	Misener 3697 Viola 3706 T.D. 3709 6" @ 3707 RUST
7/21	T.D. 3727-1000 acid flow 98 oil in 4 hrs.
7/28	Viola 3706 6" @ 3707' T.D. 3727' 1000 acid Bomb Pot 18420 Max 3000 Gravity 42

COMPLETED

KANSAS

Reno

Map No. 47 Sec. 6 Twp. 24 R. 10WWell No. 4 JohnsonSkelly

Company

FIRST REPORT

Contractor

C SENE**SECTION PLAT**

			o

 Ft. from N. Line660 Ft. from S. Line660 Ft. from E. Line Ft. from W. Line**ZENITH POOL**Location XXXRig up

Drilling and Remarks:

RECORDCased in., ft.Sand Gas Oil Total Depth **PRODUCTION**1st 24 hrs. Nat. 1st 24 hrs. after shot Gas Cu. Ft.Dry Hole Abandoned

Date

JUN 9 1943 19S. J. LEWIS

Scout

KANSAS

Map No. 47 Sec. 6 Twp. 24 R. 10WWell No. 4 JohnsonSkelly


Company

COMPLETED

Contractor

C SE NE

SECTION PLAT

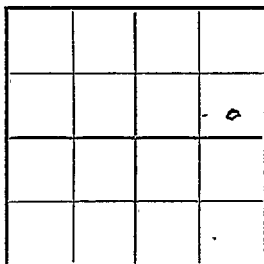 Ft. from N. Line660 Ft. from S. Line660 Ft. from E. Line Ft. from W. Line

ZENITH POOL

Location Rig up

Drilling and Remarks:

*Vidla 3206**6" @ 3207**1000 acid**Bom & Prod 17420**Max 3000**42 C Ar*

RECORD

Cased in., ft.Sand Gas Oil Total Depth 3220

PRODUCTION

1st 24 hrs. Nat. 1st 24 hrs. after shot Gas Cu. Ft.Dry Hole Abandoned

Date

JUL 28 1943 19

S. J. LEWIS Scout