

KANSAS


FORM 51 5M 1-42 PETROL

Reno

Section 6 Township 24 Range 10-W


Well No. #3 Freeman At

Company Cities Service Oil

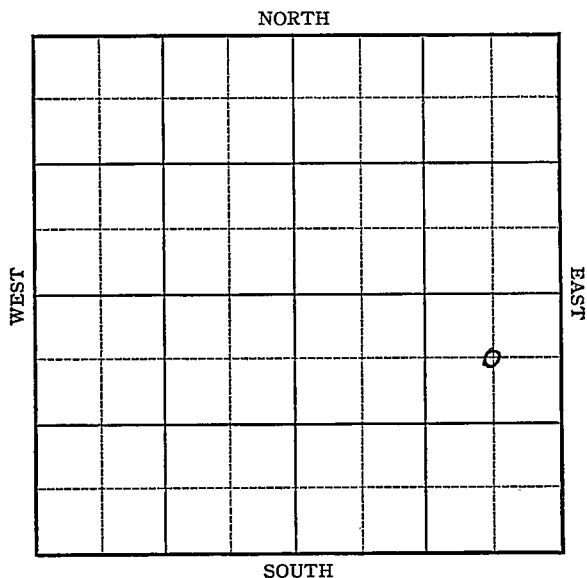

KANSAS

Reno

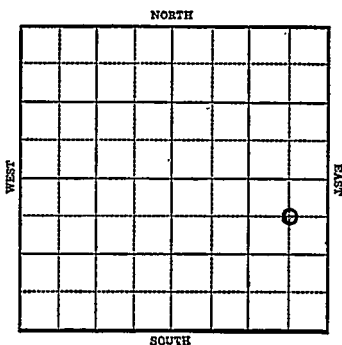Sec. 6 Twp. 24 R. 10-WWell No. #3 Freeman Farm
Cities Service Oil Company660 Ft. from N. Line Ft. from S. Line660 Ft. from E. Line Ft. from W. Line**Zenith Pool**1943 *led. 1798* R E P O R T

7/28 Surface Hole

8/4 8" @ 270'
Drlg. 2475'8/11 Viola 3724
T.D. 3734
5" @ 3729
RUST

8/18 "

8/25 "

9/1 Viola 3720 Corrected
T.D. 3730
5" @ 3725-800' oil 1000 acid9/8 Viola 3720
5" @ 3725
1000 acid
Bomb Pot. 3000
T.D. 3730**COMPLETED**

KANSAS

Reno

Map No. 47 Sec. 6 Twp. 24 R. 10WWell No. 3 FreemanCities Service Oil

Company

FIRST REPORT

Contractor

C NE SE

SECTION PLAT660 Ft. from N. Line

Ft. from S. Line

660 Ft. from E. Line

Ft. from W. Line

			o

ZENITH POOL

Location

Rig up

Drilling and Remarks:

Surface Hole**RECORD**

Cased _____ in., _____ ft.

Sand _____

Gas _____

Oil _____

Total Depth _____

PRODUCTION

1st 24 hrs. Nat. _____

1st 24 hrs. after shot _____

Gas _____ Cu. Ft.

Dry Hole _____

Abandoned _____

Date

JUL 28 1943

19

S. J. LEWIS Scout

KANSAS
 Map No. Sec. 6 Twp. 24 R. 10W

Well No. 3 Freeman

Cities Service Oil

Company

COMPLETED

Contractor

C NE SE

660 Ft. from N. Line

Ft. from S. Line

660 Ft. from E. Line

Ft. from W. Line

ZENITH POOL

SECTION PLAT

			0

Location

Rig up

Drilling and Remarks:






RECORD

Cased in., ft.

Sand

Gas

Oil

Total Depth 3230

PRODUCTION

1st 24 hrs. Nat. 545

1st 24 hrs. after shot

Gas Cu. Ft.

Dry Hole

Abandoned

Date

SEP 8 1943 19

S. J. LEWIS Scout