

ASAS


FORM 51 5M PETROL

Reno

Section 6 Township 24 Range 10-W

Well No. #4 Freeman

Company Cities Service Oil

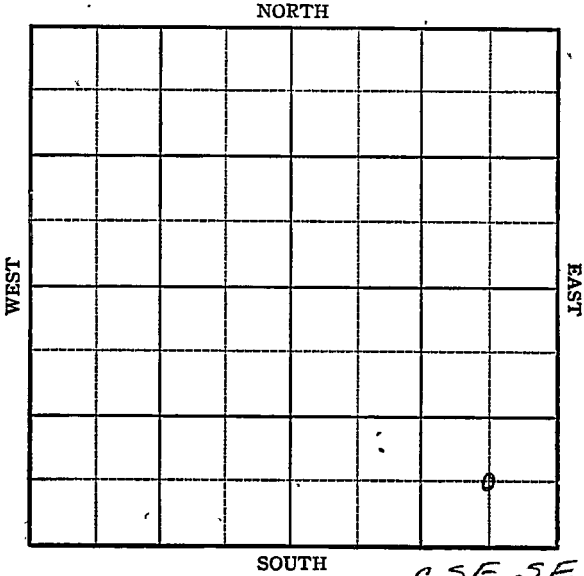

Sec. 6 Twp. 24 R. 10-W

Well No. #4 Freeman Farm


Cities Service Oil Company

\_\_\_\_\_ Ft. from N. Line

660 Ft. from S. Line

660 Ft. from E. Line

\_\_\_\_\_ Ft. from W. Line

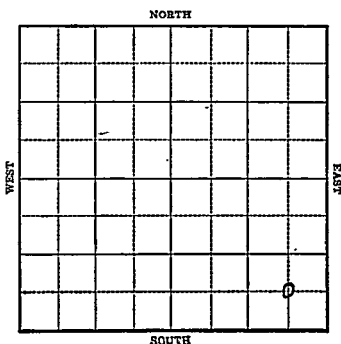

1943 *E. 1797 LS* R E P O R T

9/15 10" @ 240'  
W.O.C.

9/22 Drlg. 3280

9/29 Viola 3730-36 T.D.  
5" @ 3731'  
Rust

10/6 "

10/13 500 acid flow 33½ oil 1 hr.

10/20 Viola 3730  
5" @ 3731  
Bomb Pot 18301  
Max. 3000  
T.D. 3736  
Gravity 42

**COMPLETED**

**KANSAS**Map No. 47 Sec. 6 Twp. 24 R. 10WWell No. #4 FreemanCities Service Oil Company**FIRST REPORT**

Contractor

C SE SE

**SECTION PLAT**         Ft. from N. Line660 Ft. from S. Line660 Ft. from E. Line         Ft. from W. Line

			o

Zenith PoolLocation         Rig up         

Drilling and Remarks:

10" - 240WOC**RECORD**Cased          in.,          ft.Sand         Gas         Oil         Total Depth         **PRODUCTION**1st 24 hrs. Nat.         1st 24 hrs. after shot         Gas          Cu. Ft.Dry Hole         Abandoned         

Date

SEP 15 194319S. J. LEWIS Scout

**KANSAS**

Map No. 47 Sec. 6 Twp. 24 R. 10W

Well No. 4 Freeman

Cities Service Oil Company

**COMPLETED** Contractor

C SE SE

**SECTION PLAT**

\_\_\_\_\_ Ft. from N. Line

660 Ft. from S. Line

660 Ft. from E. Line

\_\_\_\_\_ Ft. from W. Line

			o

Zenith Pool

Location \_\_\_\_\_

Rig up \_\_\_\_\_

Drilling and Remarks:

*Vista 3730*  
*5' 10" 3731*  
*500 cu. ft.*  
*Bomb 10' 19301*  
*Map 3000*  
*42° SE*

**RECORD**

Cased \_\_\_\_\_ in., \_\_\_\_\_ ft.

Sand \_\_\_\_\_

Gas \_\_\_\_\_

Oil \_\_\_\_\_

Total Depth 323 1/2

**PRODUCTION**

1st 24 hrs. Nat. \_\_\_\_\_

1st 24 hrs. after shot \_\_\_\_\_

Gas \_\_\_\_\_ Cu. Ft.

Dry Hole \_\_\_\_\_

Abandoned \_\_\_\_\_

Date

OCT 20 1943 19

S. J. LEWIS Scout