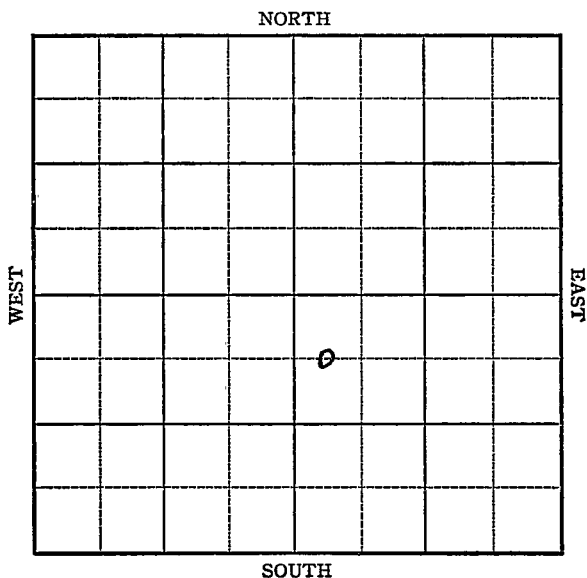


Section 6 Township 24 Range 12-WWell No. #1 FindleyCompany Iron Drilling

KANSAS

Stafford


Sec. 6 Twp. 24 R. 12-WWell No. #1 Findley FarmIron Drilling Company

(Wildcat)

660 Ft. from N. Line

Ft. from S. Line


Ft. from E. Line

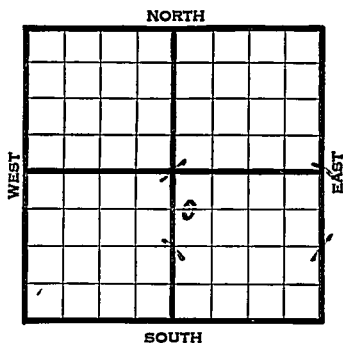330 Ft. from W. Line*Elw. 1891*

1941	REPORT
11/25	Location
12/4	"
12/11	"
12/18	Derrick
12/24	8" - 235' Anhy 719'
	Drlg. 1745'
12/31	Drlg. 2910'
1942	
1/8	Topeka 2995' Lans. 3499'
	B.K.C. 3753' Cong. 3769'
	Viola ³⁸²⁸ 3795 Drlg. 3819'
1/14	Simp. 3940'
	Viola 3828' (Corrected)
	T.D. 3951'
	Water.
	ABANDONED

Map No. K-47 Sec. 6 Twp. 24 R. 12WWell No. 1 FindleyIron Drilling CompanyFIRST REPORT Contractor~~G NE NW SW~~660 Ft. from N. Line Ft. from S. Line Ft. from E. Line330 Ft. from W. Line

SECTION PLAT

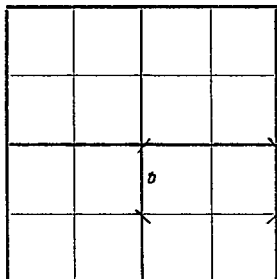

WILDCAT

Location XXRig up

Drilling and Remarks:

RECORD

Cased in., ft.Sand Gas Oil Total Depth

PRODUCTION

1st 24 hrs. Nat. 1st 24 hrs. after shot Gas Cu. Ft.Dry Hole Abandoned

Date

NOV 25 1941

19

S. J. LEWIS

Scout

Stafford

KANSASMap No. 47 Sec. 6 Twp. 24 R. 12WWell No. 1 FindleyIron Drilling CompanyABANDONED Contractor

Q WL NW SE

SECTION PLAT

660 Ft. from N. Line Ft. from S. Line Ft. from E. Line330 Ft. from W. Line

		o	

WILDCAT

Location Rig up

Drilling and Remarks:

Snip 3940
Vib 3828 oriented
Water.

RECORD

Cased in., ft.Sand Gas Oil Total Depth 3831

PRODUCTION

1st 24 hrs. Nat. 1st 24 hrs. after shot Gas Cu. Ft.Dry Hole Abandoned

Date

JAN 14 1942 19

S. J. LEWIS Scout