

KANSAS

Stafford

Section 6 Township 24 Range 13WWell No. 2 HuntCompany Petroleum, Inc.

St. Johns Pool

NORTH

WEST

							0

EAST

SOUTH

Stafford **KANSAS**

Sec. 6 Twp. 24 R. 13W

Well No. #2 Hunt Farm

Petroleum, Inc.


St. Johns Pool (Drillers, Inc., Cont.) Company

 Ft. from N. Line

990' Ft. from S. Line

330' Ft. from E. Line

 Ft. from W. Line

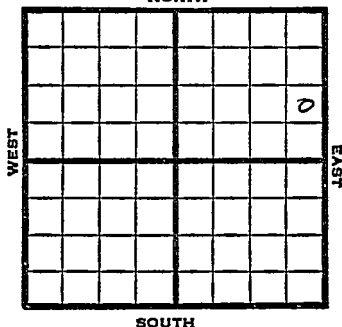

NE SE NE

1949 Elev. 1916' REPORT

9/21 8" @ 315'
Anhy 790'
Drlg. 2100'

10/5 Lans. 3555'
TD 3686'
Abd.

ABANDONED

Map No. _____ Sec. 6 Twp. 24 R. 13W

Well No. 2nd Hunt

Petroleum Inc. _____ Company

Drillers Inc. _____ Contractor

NE SE FE

**FIRST REPORT
SECTION FLAT**

			o

_____ Ft. from N. Line

990 _____ Ft. from S. Line

330 _____ Ft. from E. Line

_____ Ft. from W. Line

Stafford County

Location _____

Rig up _____

Drilling and Remarks:

8" @ 315

Anhy 790

drlg. 2100

RECORD

Cased _____ in., _____ ft.

Sand _____

Gas _____

Oil _____

Total Depth _____

PRODUCTION

1st 24 hrs. Nat. _____

1st 24 hrs. after shot _____

Gas _____ Cu. Ft.

Dry Hole _____

Abandoned _____

Date

SEP 21 1949

19

S. J. LEWIS

Scout

AANS28

Map No. _____ Sec. 6 Twp. 24 R. 13WWell No. 2 Hunt

Petroleum Inc.

Company

ABANDONED

Contractor

NE SE NE

E 11/19/6
SECTION PLAT

			6

_____ Ft. from N. Line

990 Ft. from S. Line330 Ft. from E. Line

_____ Ft. from W. Line

Stafford County

Location _____

Rig up _____

Drilling and Remarks:

*Same 3555***RECORD**

Cased _____ in. _____ ft.

Sand _____

Gas _____

Oil _____

Total Depth 3686**PRODUCTION**

1st 24 hrs. Nat. _____

1st 24 hrs. after shot _____

Gas _____ Cu. Ft.

Dry Hole _____

Abandoned _____

Date

OCT 5 1949

19

S. J. LEWIS

Scout