


Section 6 Township 24 Range 13W

Well No. #1 Rusmiser

Company Hilton Drlg.

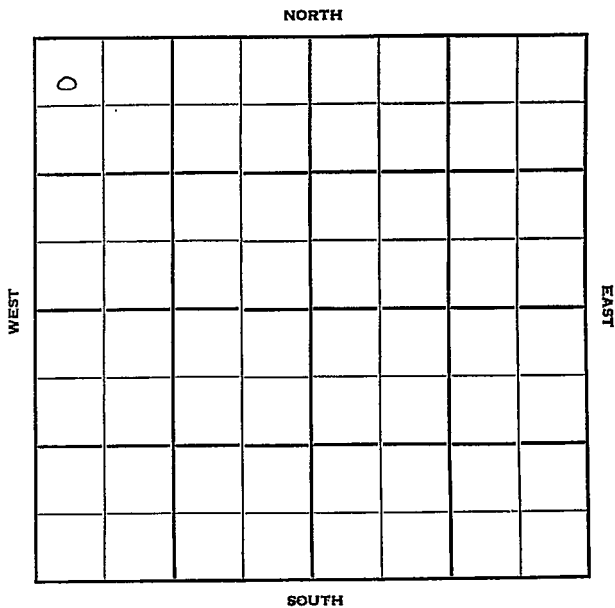

Stafford

KANSAS

Sec. 6 Twp. 24 R. 13W

Well No. #1 Rusmiser Farm

Hilton Drlg. Company

Contractor

Merle

330 Ft. from N. Line

_____ Ft. from S. Line


_____ Ft. from E. Line

330 Ft. from W. Line

NW NW NW

Magnolia FO

Sinclair- DHM

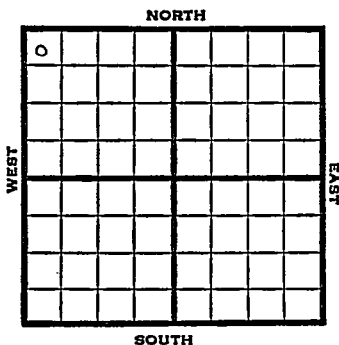

1951

Elev. 1905' REPORT

10/10 Location

12/5 Spud 11-13-51
 D & A TD 4150' 8" @ 224'
 Anhy 780' Heeb 3409' Br. lime
 3542' Lans. 3570' Viola 3541'
 Arb. 4100-50' TD
 D & A

ABANDONED

County Stafford State Kansas

Sec. 6 (Blk. Twp.) 24 (Sur. Rge.) 13W Map No.

Operator Hilton Drlg.

Well No. I Farm Rusmiser

Elev. Location NW NW NW

FIRST REPORT									

330 Ft. From N Line NW

330 Ft. From W Line Quarter

Ist. Report OCT 10 1951

Completion

Remarks Magnolia *F.O.

Sinclair - DHE

Spudding Date

Drlg. Data Merle

Location

J. E. TYRA

County Stafford State Kansas

Sec. 6 (Blk. Twp.) 24 (Sur. Rge.) 13W Map No.

Operator Hilton Drlg.

Well No. 1 Farm Rusmisl

Elev. 1905 Location NW NW NW

0					

BANDONED

330 Ft. From N Line NW

330 Ft. From W Line Quarter

1st. Report

Completion DEC 5 1951

Remarks Merle Pool

Spudding Date 11-13-51

Drlg. Data D & A TD 4150

8" @ 224 Anhy 780 Heeb. 3409

Br. lime 3542 Lans. 3570 Viola 3541

Arb. 4100-50 TD

D & A