

KANSAS


FORM 51 25M 3-49 PETROL

Stafford

Section 6 Township 24 Range 14-W

Well No. #1 Crouse

Company Musgrove Petroleum

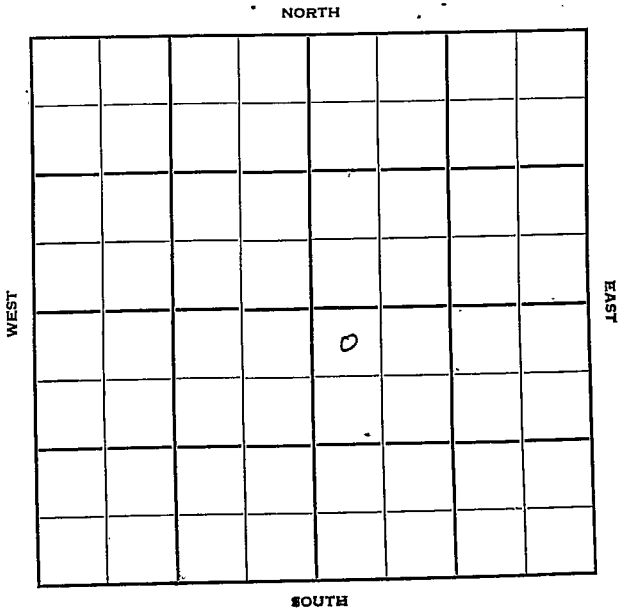

Stafford

KANSAS

Sec. 6 Twp. 24 R. 14W

Well No. #1 Crouse Farm

Musgrove Petr.

Company

Contractor

Wildcat


330' Ft. from N. Line

Ft. from S. Line

Ft. from E. Line

330' Ft. from W. Line

NW NW SE

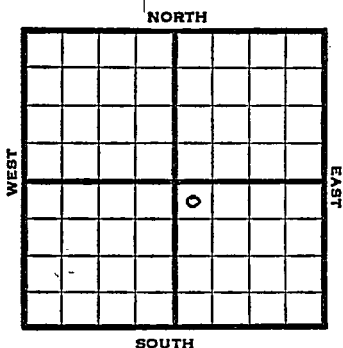

1950

Elev. 1993' REPORT

9/6

Spud 8-31-50
Drlg. 2000'

9/20

Spud 8-31-50
D&A TD 4150'
8-5/8" @ 231'

Anhy 915'

Dodge 3502'

Heeb. 3482'

Br Lime 3622'

KC 3632'

Cong. 3968'

Vtola 3979'

Simp. 4049'


DST 4054-60 opn 1 hr Rec. 6' mud

Arb. 4093'

D&A

ABANDONED

County Stafford State Kansas
 Sec. 6 (Blk.) 24 (Sur.) 14W Map No.
 Operator Musgrove Petroleum
 Well No. 1 Farm Crouse
 Elev. _____ Location NW NW SE

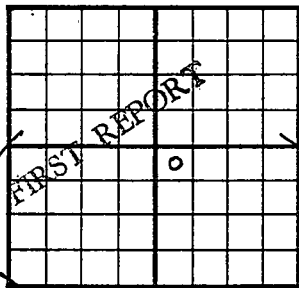

330 Ft. From N Line SE
330 Ft. From W Line Quarter
 Ist. Report SEP 6 1950

Completion _____

Remarks _____

Shell DEM


Spudding Date 8-31-50

Drlg. Data _____

Wildcat

drlg. 2000

J. E. TYRA

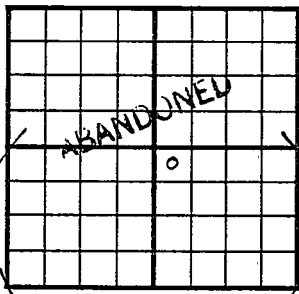County Stafford State KansasSec. 6 (Blk.) 24 (Sur.) 14W Map No.Operator Musgrove PetroleumWell No. 1 Farm CrouseElev. 1993 Location NW NW SE330 Ft. From N Line SE330 Ft. From W Line Quarter1st. Report ~~SEP 20 1950~~Completion SEP 20 1950

Remarks

WildcatSpudding Date 8-31-50Drilg. Data D & A TD 41508 5/8" @ 213 Anhy 915 Heeb. 3482Dodge 3502 Br. lime 3622 KC 3632Cong. 3968 Viola 3979 Simp. 4049DST 4054-60 open 1 hr. Rec. 6' mudArb. 4093-4150 TD D & A

J. E. TYRA