


Section 6 Township 24 Range 15W
 Well No. #2 Bradbridge
 Company Lewis Drlg.

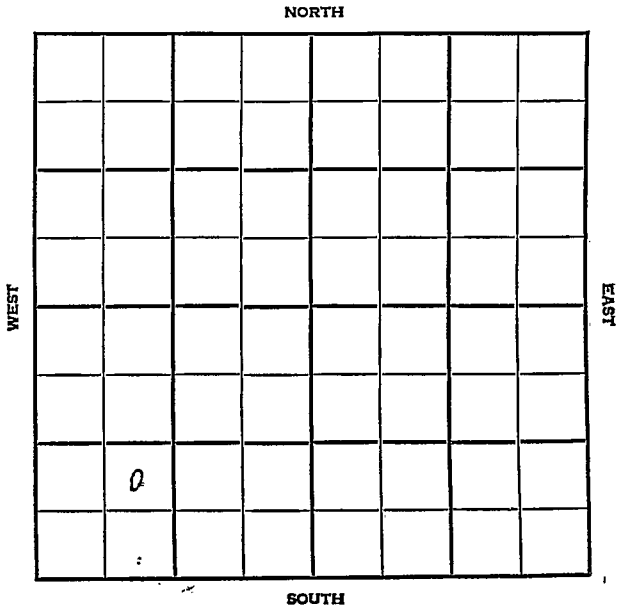

Stafford

KANSAS

SEC.	TWP.	R.
6	24	15W

WELL NO.

#2 Bradbridge

FARM

COMPANY

Lewis Drlg.

CONTRACTOR

Lewis

Bradbridge Pool

NORTH

Ft. from N. Line


990

Ft. from S. Line

Ft. from E. Line

990

Ft. from W. Line

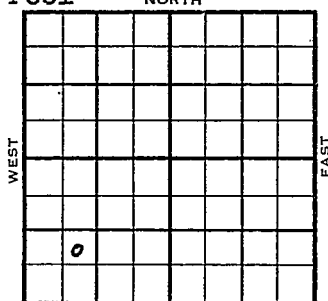

NE SW SW

SOUTH

	ELEVATION	REPORT
1954	2043'	

11/3 Spud 10-28-54
8 @ 296'
Drlg. 3340'

11/10 Spud 10-28-54
D & A
TD 4153'
8" @ 296'

Heeb 3532' Br. Lime 3664' KC 3671'
DST 3702' 36' opn 1 hr, rec 30' Mud 0#
B KC 3931', Cong 3991', Viola 4053'
DST 4050'-65' opn 1 hr, rec 40' Mud
420# Simp 4078' Arb. 4148'
DST 4139'-53' opn 1 hr, rec 530' mw
VSSO 830#
TD 4153'
D & A

ABANDONED

County Stafford State Kansas

Sec. 6 (Blk. Twp.) 24 (Sur. Rge.) 15W Map No.

Operator Lewis Drlg.

Well No. **2** Farm **Bradbridge**

Elev.	Location	NE	SW	SW
-------	----------	----	----	----

FIRST REPORT

990 Ft. From S Line . SW

990 Ft. From VI Line Quarter

1st. Report NOV 3 1954

Completion

Remarks

Lewis - Contr.

Spudding Date **10-28-54**

Drlg. Data Bradbridge Pool

8" @ 296 drlg. 3340


