


Harvey

KANSAS

SECTION 7 TOWNSHIP 24S RANGE 2W

WELL NO. #3 Wear

COMPANY Birmingham & Bartlett

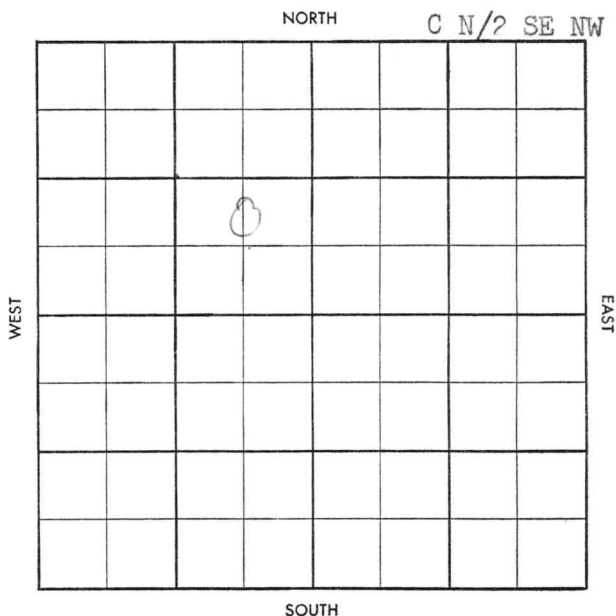

WILDCAT

S-513-A

CO. Harvey ELEV.

SEC. 7 TWP. 24 RGE. 2W

COMPANY Birmingham & NO. 3

Bartlett

FARM WOLF

LOC. C N/2 SE NW

[illegible]

GEOL.

CONTR. Co. Tools

POOL Wildcat

SPUD 11/4/57

8" @ 477 - WOC

00

USE

NO

SEC

TWP

RGE

CO. Harvey ELEV. 1426 DFSEC. 7 TWP. 24 RGE. 2WCOMPANY Birmingham & NO. 3BartlettFARM WearLOC. C N/2 SE 1W

NOV 20 1957

CO.

LSE.

NO.

SEC.

TWP.

RGE.

GEOL. _____

CONTR. Co. ToolsPOOL WildcatSPUD 11/14/57

8" 477 - MOC 3224

NOV 20 1957

A 457 H 62303 L 2530M. 55 3345 Hunt 3784DST 3746 - 62 15" 5' Mall 0 DST 3776 - 86 60"270' SOC SW + 1020' SW BHP1375 DST 3787 - 90 60" 450' SWBHP 1380 SY/UMH SH 3811V 3882 S 3901 RTN 3906ran by D & A