

# KANSAS


FORM 51 5M 10-41 PETROL

Reno

Section 7 Township 24 Range 10-W

Well No. #1 Porter

Company Landon

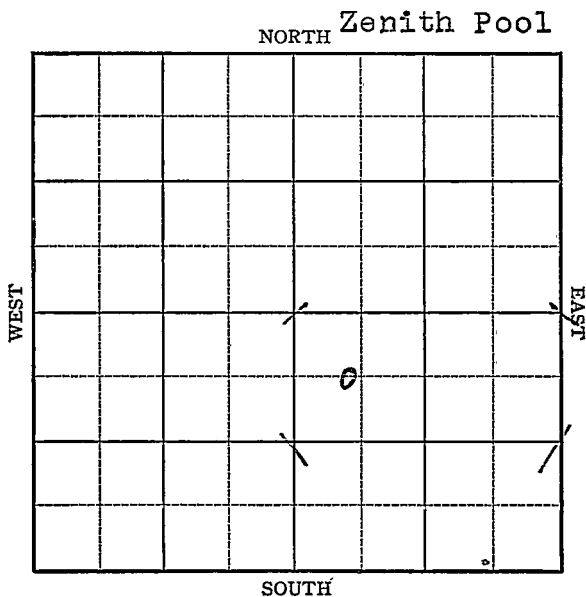




Map No. 47 Sec. 7 Twp. 24 R. 10WWell No. 1 PorterLandon

Company

**FIRST REPORT**

Contractor

C NW SE

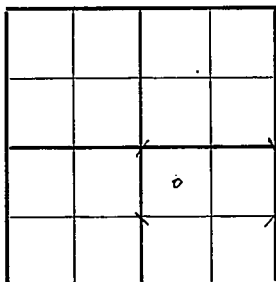660 Ft. from N. Line       Ft. from S. Line       Ft. from E. Line510 Ft. from W. Line**SECTION PLAT****ZENITH POOL**Location                                 Rig up                                 

Drilling and Remarks:

8" - 195'Anhy. 460'Dr1g. 1905'**RECORD**Cased            in.,            ft.Sand                                 Gas                                 Oil                                 Total Depth                                 **PRODUCTION**1st 24 hrs. Nat.                                 1st 24 hrs. after shot                                 Gas                                  Cu. Ft.Dry Hole                                 Abandoned                                 

Date

MAR 1 8 1942 19S. J. LEWIS

Scout

**KANSAS**Map No. 47 Sec. 7 Twp. 24 R. 10WWell No. 1 PorterLandon

Company

**ABANDONED**

Contractor

C NW SE

**SECTION PLAT**660 Ft. from N. Line       Ft. from S. Line       Ft. from E. Line510 Ft. from W. Line

|  |  |   |  |
|--|--|---|--|
|  |  |   |  |
|  |  |   |  |
|  |  | o |  |
|  |  |   |  |

**ZENITH POOL**Location                     Rig up                     

Drilling and Remarks:

*Vista 3692**5" C 3692**No show***RECORD**Cased            in.,            ft.Sand                     Gas                     Oil                     Total Depth 3238**PRODUCTION**1st 24 hrs. Nat.                     1st 24 hrs. after shot                     Gas                      Cu. Ft.Dry Hole                     Abandoned                     

Date

APR 22 194219S. J. LEWIS Scout