

# KANSAS


FORM 51 5M 10-41 PETROL

Reno

Section 7 Township 24 Range 10-W

Well No. #2 Porter

Company Hall & Landon

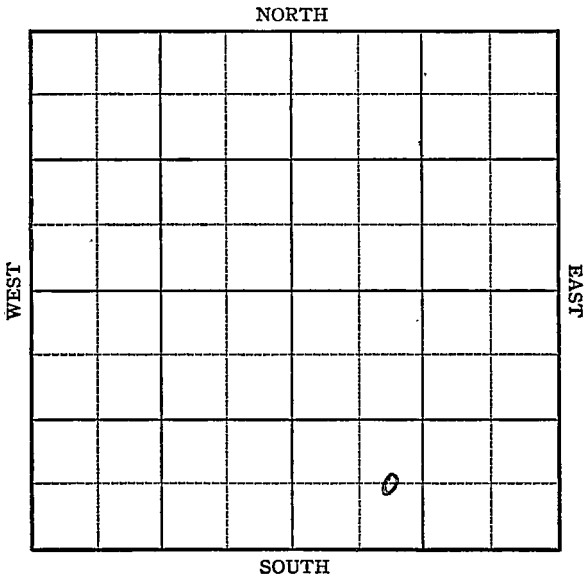



1942  
1/14

Viola 3702<sup>r</sup>  
6" - 3716<sup>r</sup>  
T.D. 3774<sup>r</sup>  
Ripped casing 3703-10<sup>r</sup>  
3000 acid.  
Potential 235 bbls., flow.  
39.6 Gravity

**COMPLETED**

Reno

**KANSAS**

Map No. X-47 Sec. 7 Twp. 24 R. 10W

Well No. 2 Porter

Hall & Landon Company

**FIRST REPORT** Contractor

C EL SW SE

\_\_\_\_\_ Ft. from N. Line

660 Ft. from S. Line

\_\_\_\_\_ Ft. from E. Line

990 Ft. from W. Line

**SECTION PLAT**


ZENITH POOL

Location XX

Rig up \_\_\_\_\_

Drilling and Remarks:

**RECORD**

Cased \_\_\_\_\_ in., \_\_\_\_\_ ft.

Sand \_\_\_\_\_

Gas \_\_\_\_\_

Oil \_\_\_\_\_

Total Depth \_\_\_\_\_

**PRODUCTION**

1st 24 hrs. Nat. \_\_\_\_\_

1st 24 hrs. after shot \_\_\_\_\_

Gas \_\_\_\_\_ Cu. Ft.

Dry Hole \_\_\_\_\_

Abandoned \_\_\_\_\_

Date

NOV 12 1944

S. J. LEWIS

Scout

Map No. 47 Sec. 7 Twp. 24 R. 10WWell No. 2 PorterHall & Landon CompanyCOMPLETED Contractor

C E L S W S E

## SECTION PLAT

         Ft. from N. Line660 Ft. from S. Line         Ft. from E. Line990 Ft. from W. Line


ZENITH POOL

Location                                 Rig up                                 

Drilling and Remarks:

*Viola 3702*  
*6" @ 3716*  
*Ripped Log 3703-10*  
*3000 acid.*  
*Flow 230 Pst*  
*39 1/2 G*

## RECORD

Cased          in.,          ft.Sand                                 Gas                                 Oil                                 Total Depth 3774

## PRODUCTION

1st 24 hrs. Nat.                                 1st 24 hrs. after shot                                 Gas                                  Cu. Ft.Dry Hole                                 Abandoned                                 

Date

JAN 14 194219S. J. LEWIS Scout