

KANSAS

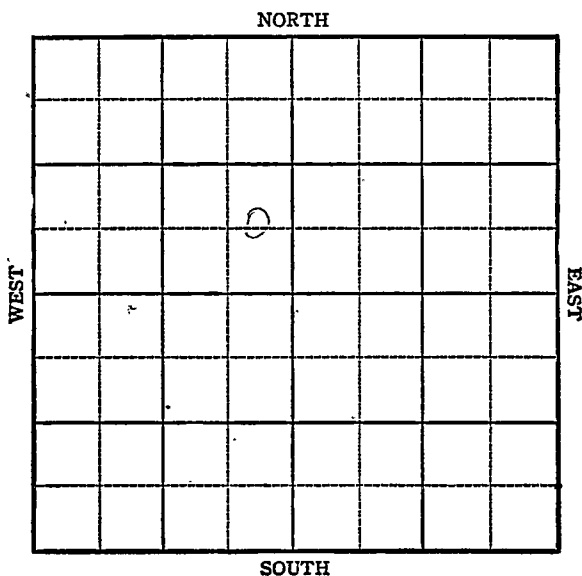
Reno

FORM 51 SM BRIX

Section 7 Township 24 Range 10W

Well No. #10 Union Central

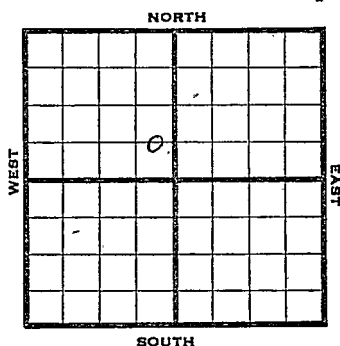
Company Texas



KANSAS

Sec. 7 Twp. 24 R. 10WWell No. #10 Union Central FarmTexas Company

Peace Creek

 Ft. from N. Line660 Ft. from S. Line330 Ft. from E. Line Ft. from W. LineReno SEL SE NW

1944

Elev. 1793 REPORT

11/29 Loc.

12/6 RUR

12/14 10" @ 238' Drlg. 1642'

12/21 Drlg. 2636'

12/29 Drlg. 3573'

1945

1/3 Misener 3713 Viola 3721 25

TD 7" @ 3774 Rust

1/10 " " " "

1/17 " " " "

1/26 36 shots 3722-3734
1000 acid swb. 48 oil in 24 hrs.1/31 35 shots 3741-3752 1000 acid
Swab. 80 oil in 10 hrs.

2/7 " " " " " "

2/14 " " " " " "

2/21 Viola 3721

7" @ 3724

Perf. Viola 2000 acid

TD 3775

Pump 80 oil plus 40 water.

Pot.

Grav. 42.0

COMPLETED

Pool Name Peace CreekMap No. 47 Sec. 7 Twp. 24 R. 10WWell No. 10 Union CentralTexas CompanyFIRST REPORT Contractor

CEL SE NW

SECTION PLAT

 Ft. from N. Line660 Ft. from S. Line330 Ft. from E. Line Ft. from W. Line

Reno

Location XRig up Drilling and Remarks:

RECORD

Cased in. ft.Sand Gas Oil Total Depth

PRODUCTION

1st 24 hrs. Nat. 1st 24 hrs. after shot Gas Cu. Ft.Dry Hole Abandoned

Date

NOV 29 1944

19

S. J. LEWIS Scout

Pool Name Peace CreekMap No. 47 Sec. 7 Twp. 24 R. 10WWell No. 10 Union CentralTexas

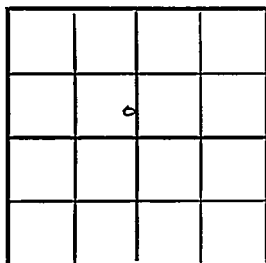
Company

COMPLETED

Contractor

C E L S E N W

SECTION PLAT

Ft. from N. Line660 Ft. from S. Line330 Ft. from E. LineFt. from W. LineReno County

Location

Rig up

Drilling and Remarks:

*Vista 3721**7" 03774**Perf Vista**2000 acid**Perf 800 ft + 400 ft**Perf 420 ft*

RECORD

Cased in., ft.Sand Gas Oil Total Depth 3725

PRODUCTION

1st 24 hrs. Nat. 1st 24 hrs. after shot Gas Cu. Ft.Dry Hole Abandoned

Date

FEB 21 194519S. J. LEWISScout