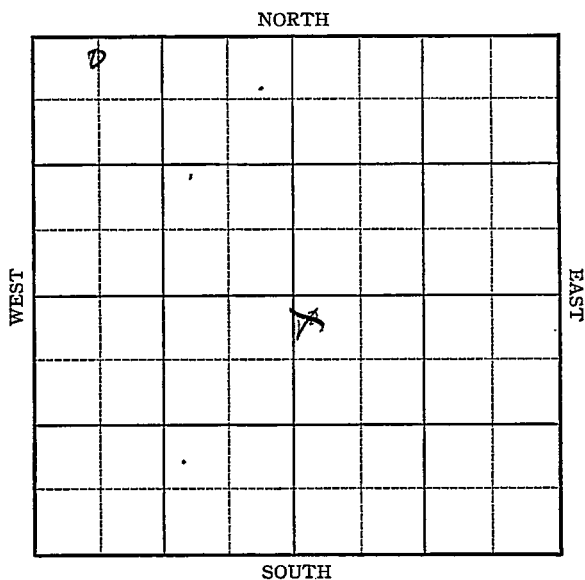


KANSAS

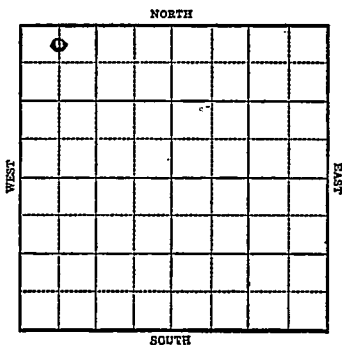
Section 7 Township 24 Range 10WWell No. 8 Union Central LifeCompany A.M. Landon

KANSAS

Reno

Sec. 7 Twp. 24 R. 10-WWell No. #8 Union Central Life FarmA. M. Landon Company

Zenith Pool

330 Ft. from N. Line Ft. from S. Line Ft. from E. Line660 Ft. from W. Line*Elev. 1822'*

1942

R E P O R T

10/21	Drlg. 959'	8"- 255'
10/28	Drlg. 2700	
11/4	Drlg. 3510	
11/11	Misiner 3717 SO	
	Viola 3723	
	TD 3732' SS0	
	5" @ 3727' RUST	
11/18	" "	
11/24	TD 3779-1200(oil & sw PB.	
12/2	TD 3784	
	PB 3750	
12/9	PB 375-bail $\frac{1}{4}$ bbl flud per hr	
	50 per cent water.	
12/16	TD 3771 testing.	
12/22	" "	
12/29	" "	
1943		
1/6	" "	
1/13	" "	
1/20	" "	

OVER

1943

1/27 PB3774 $\frac{1}{2}$ -3000 acid
Pump 24 bbls fluid per hr 60%
water for 40 hrs.

2/3 Viola 3736
T.D. 3784'
P.B. 3774 $\frac{1}{2}$ '
3000 gal acid
Pump 200 bbl oil plus 370 bbl water
Pot.
Gravity 41.6

COMPLETED

Reno KANSAS

Map No. 47 Sec. 7 Twp. 24 R. 10WWell No. 8 Union Central LifeA. M. Landon

Company

FIRST REPORT

Contractor

C NL NW NW

330 Ft. from N. Line Ft. from S. Line Ft. from E. Line660 Ft. from W. Line

SECTION PLAT

0			

ZENITH POOL

Location Rig up

Drilling and Remarks:

8"-255'

Drilg. 959'

RECORD

Cased in., ft.Sand Gas Oil Total Depth

PRODUCTION

1st 24 hrs. Nat. 1st 24 hrs. after shot Gas

Cu. Ft.

Dry Hole Abandoned

Date

OCT 21 1942

19

S. J. LEWIS

Scout

Reno

KANSAS

Map No. 47 Sec. 7 Twp. 24 R. 10WWell No. 8 Union Central Life

A. M. Landon

Company

COMPLETED

Contractor

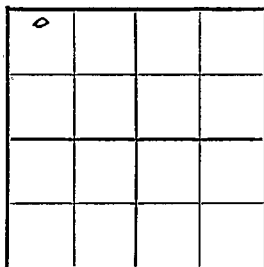
C NL NW NW

SECTION PLAT

330 Ft. from N. Line

Ft. from S. Line

Ft. from E. Line

660 Ft. from W. Line

ZENITH POOL

Location

Rig up

Drilling and Remarks:

*Vidla 3786**PB 3774 1/2**3000 bail**Pump 200 oil 370 water**Px**416 Gr*

RECORD

Cased _____ in., _____ ft.

Sand _____

Gas _____

Oil _____

Total Depth 3784

PRODUCTION

1st 24 hrs. Nat. _____

1st 24 hrs. after shot _____

Gas _____ Cu. Ft.

Dry Hole _____

Abandoned _____

Date

FEB 3 1943 19

S. J. LEWIS Scout