

KANSAS

Section 7 Township 24S Range 11W


Well No. #1 Ransom

Company L. E. Whitlock

NORTH

WEST

EAST

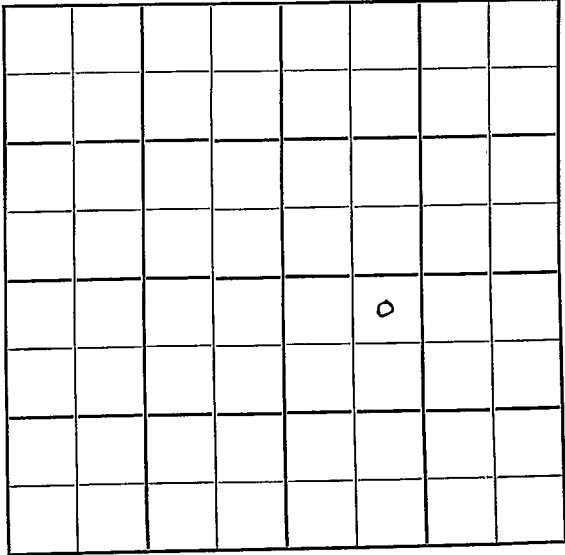

SOUTH

Sec. 7 Twp. 24 R. 11-W

Well No. #1 Ranson Farm

L E Whitlock Company


Opnt. -- B & R Drlg
Peace Creek

330 Ft. from N. Line

_____ Ft. from S. Line

_____ Ft. from E. Line

990 Ft. from W. Line

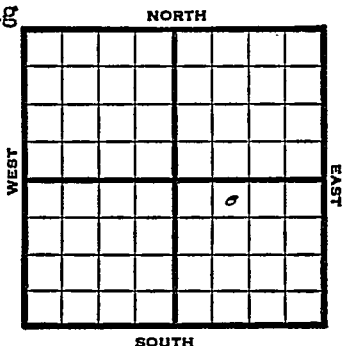

NE NW SE .

1949 Elev. 1833' REPORT

10/5 8" @ 248'

10/12 Drlg 2612'

10/19 Viola 3810'

TD 3813'

5" @ 3810'

10/26 "

11/1 "

11/9 TD 3826'

4000 acid

11/16 TD 3845'

PB 3826'

4500 acid

Swb 2 1/2 bbls oil / 3 W PH 24 hrs.

11/23 "

11/29 "

12/7 "

12/14 Viola 3810'

5" @ 3810'

Acid 4500

Pump 20 oil Pot.

TD 3845'

Gr. 41°

COMPLETED

KANSAS

Map No. _____ Sec. 7 Twp. 24 R. 11W

Well No. 1 Ranson

L. E. Whitlock _____ Company

B & R Drlr. _____ Contractor

NE NW SE

FIRST REPORT
SECTION PLAT

330 Ft. from N. Line

_____ Ft. from S. Line

_____ Ft. from E. Line

990 Ft. from W. Line

		o	

Stafford County

Location _____

Rig up _____

Drilling and Remarks:

8" @ 248

RECORD

Cased _____ in., _____ ft.

Sand _____

Gas _____

Oil _____

Total Depth _____

PRODUCTION

1st 24 hrs. Nat. _____

1st 24 hrs. after shot _____

Gas _____ Cu. Ft.

Dry Hole _____

Abandoned _____

Date

OCT 5 1949 19

S. J. LEWIS Scout

Map No. _____ Sec. 7 Twp. 24 R. 11W

Well No. 1 Ranson

L. E. Whitlock Company

COMPLETE

Contractor

NE NW SE

E 1173
SECTION PLAT

330 Ft. from N. Line

_____ Ft. from S. Line

_____ Ft. from E. Line

990 Ft. from W. Line

		0	

Stafford County

Location _____

Rig up _____

Drilling and Remarks:

Via to 3870
5" @ 3870
4500 sand
Prod. 20 wells
412 3/4

RECORD

Cased _____ in., _____ ft.

Sand _____

Gas _____

Oil _____

Total Depth 3870

PRODUCTION

1st 24 hrs. Nat. _____

1st 24 hrs. after shot _____

Gas _____ Cu. Ft.

Dry Hole _____

Abandoned _____

Date

DEC 14 1949 19

S. J. LEWIS Scout