


Section 7 Township 24 Range 11W

Well No. #2 Richardson

Company Transwestern

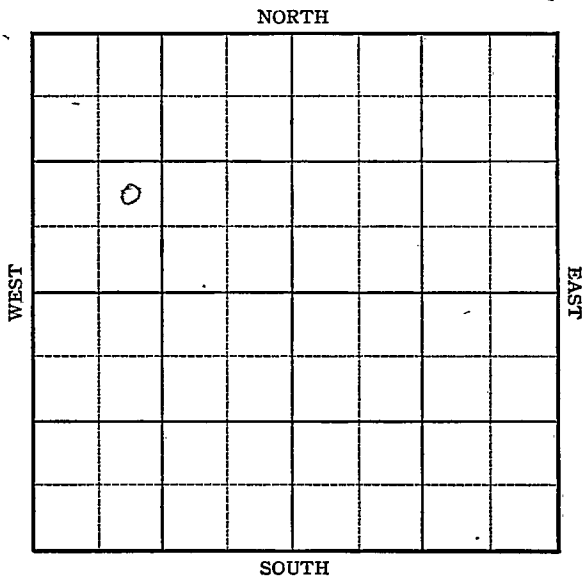

Sec. 7 Twp. 24 R. 11W

Well No. #2 Richardson Farm

Transwestern

Company


Ranson

_____ Ft. from N. Line

990 Ft. from S. Line

_____ Ft. from E. Line

990 Ft. from W. Line

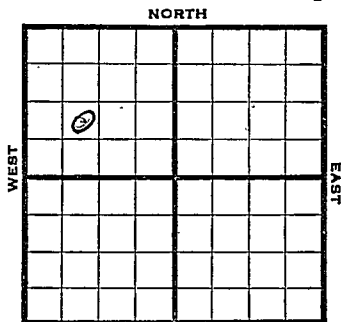

NE SW NW Elev. 1842 SOUTH

1945

R E P O R T

3/7	Location
3/14	8" @ 295 Drlg 2000
3/23	Drlg. 3309'
3/29	Lans 3416 Viola 3799 3800 TD 5" @ 3799 RUST
4/5	300' oil in 6 hrs. 1000 acid
4/12	TD 3806 1000 acid. Pump 3 oil plug 6% wtr. PH
4/20	" " " " " " "
4/27	" " " " " " "
5/3	" " " " " " "
5/16	Viola 3799 5" @ 3799 TD 3806 1000 acid. Pump 164 oil plus 5% wtr. Bot. Grav. 37.0

COMPLETED

Pool Name RansonMap No. 47 Sec. 7 Twp. 24 R. 11WWell No. 2 RichardsonTranswestern

Company

FIRST REPORT

Contractor

NE SW NW

SECTION PLAT

o			

_____ Ft. from N. Line

990 Ft. from S. Line

_____ Ft. from E. Line

990 Ft. from W. LineStaffordLocation X

Rig up _____

Drilling and Remarks:

RECORD

Cased _____ in., _____ ft.

Sand _____

Gas _____

Oil _____

Total Depth _____

PRODUCTION

1st 24 hrs. Nat. _____

1st 24 hrs. after shot _____

Gas _____ Cu. Ft.

Dry Hole _____

Abandoned _____

Date

MAR 7 1945 19S. J. LEWIS

Scout

