

KANSAS


Stafford

FORM 51 5M 1-42 PETROL

Section 7 Township 24 Range 11 W

Well No. # 2 Ranson

Company Magnolia

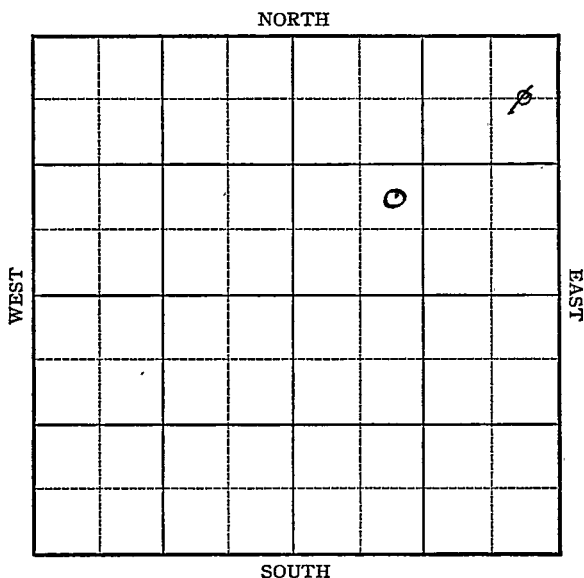

KANSAS

Stafford

Sec. 7 Twp. 24 R. 11W

Well No. # 2 Ranson Farm

Magnolia Company


Ranson

660 Ft. from N. Line

990 Ft. from S. Line

330 Ft. from E. Line

990 Ft. from W. Line

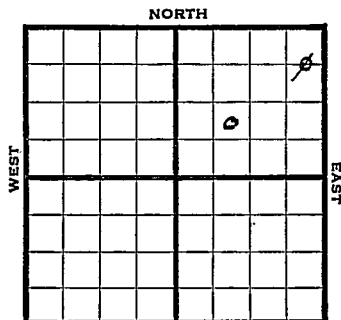

Elev ~~1844~~ 1838

1944

REPORT

5/10	Loc
5/17	"
5/24	"
5/31	"
6/7	"
6/15	"
6/21	10" @ 286 WOC
6/28	Drlg 3045
7/19	5" @ 3793
	Viola 3792
	TD 3795
	1000 gallons acid
	Bomb Pot. 3056
	Max 3000
	Gravity 42.0

COMPLETED

KANSAS

Pool Name RansonMap No. 47 Sec. 7 Twp. 24 R. 11WWell No. 2 RansonMagnolia

Company

FIRST REPORT

Contractor

C E L N E T E

SECTION PLAT

660 Ft. from N. Line Ft. from S. Line330 Ft. from E. Line Ft. from W. Line

Stafford CountyLocation XRig up

Drilling and Remarks:

RECORD

Cased in., ft.Sand Gas Oil Total Depth

PRODUCTION

1st 24 hrs. Nat. 1st 24 hrs. after shot Gas Cu. Ft.Dry Hole Abandoned

Date

MAY 10 1944

19

S. J. LEWIS

Scout

KANSAS

FORM 28 200 BKS 1 44 PETROL

Pool Name Ranson

Map No. 47 Sec. 7 Twp. 24 R. 11W

Well No. 2 Ranson

Magnolia Company

CORRECTION Contractor

NE SW NE

SECTION PLAT

 Ft. from N. Line

990 Ft. from S. Line

 Ft. from E. Line

990 Ft. from W. Line

Stafford County

Location

Rig up

Drilling and Remarks:

Reported

C E L NE NE

RECORD

Cased in. ft.

Sand

Gas

Oil

Total Depth

PRODUCTION

1st 24 hrs. Nat.

1st 24 hrs. after shot

Gas Cu. Ft.

Dry Hole

Abandoned

Date

JUN 21 1944 19

S. J. LEWIS Scout

Pool Name RansonMap No. KANSAS Sec. 7 Twp. 24 R. 11WWell No. 2 RansonMagnolia

Company

COMPLETED

Contractor

NE SW NE

SECTION PLAT

		0	

Ft. from N. Line

990

Ft. from S. Line

Ft. from E. Line

990

Ft. from W. Line

Stafford County

Location

Rig up

Drilling and Remarks:


RECORD

Cased _____ in., _____ ft.

Sand _____

Gas _____

Oil _____

Total Depth 3785

PRODUCTION

1st 24 hrs. Nat. _____

1st 24 hrs. after shot _____

Gas _____ Cu. Ft.

Dry Hole _____

Abandoned _____

Date

JUL 1 9 1944 19

S. J. LEWIS

Scout