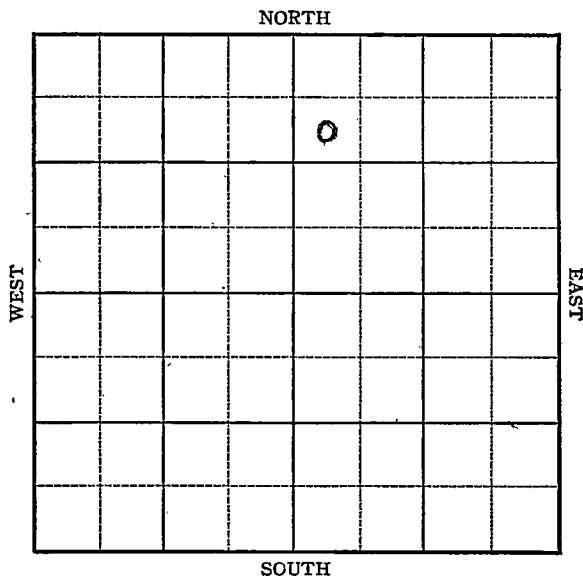


KANSAS

Stafford

Section 7 Township 24 Range 11WWell No. #3 RansonCompany Magnolia

Sec. 7 Twp. 24 R. 11W

Well No. #3 Ranson Farm

Magnolia

Company


Ranson

990 Ft. from N. Line

 Ft. from S. Line

 Ft. from E. Line

330 Ft. from W. Line

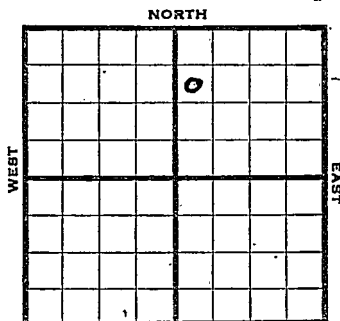

SW NW NE Elev. 1836

1945

R E P O R T

2/28 Location
3/7 "
3/14 8" @ 288 WOC
3/23 Drlg. 2685'
3/29 Lañs 3397
Viola 3771-82
- TD 3382 Sat.
5" @ 3776 RUST
4/5 TD 3784 1000 acid.
Swab 9 oil per hr.
4/11 Viola 3771
5" @ 3776
TD 3784'
3000 acid.
Pump 122 Pot.
Grav. 42.0

COMPLETED

Pool Name RansonMap No. 47 Sec. 7 Twp. 24 R. 11WWell No. 3 RansonMagnolia Company

FIRST REPORT

Contractor

SW NW NE

SECTION PLAT

990 Ft. from N. Line Ft. from S. Line Ft. from E. Line330 Ft. from W. Line

		o	

Stafford CountyLocation XRig up Drilling and Remarks:

RECORD

Cased in., ft.Sand Gas Oil Total Depth

PRODUCTION

1st 24 hrs. Nat. 1st 24 hrs. after shot Gas Cu. Ft.Dry Hole Abandoned

Date

FEB 28 1945 19S. J. LEWIS

Scout

Kansas

Pool Name RansonMap No. 47 Sec. 7 Twp. 24 R. 11WWell No. 3 RansonMagnolia

Company

COMPLETE

Contractor

SW NW NE

SECTION PLAT

990 Ft. from N. Line

Ft. from S. Line

Ft. from E. Line

330 Ft. from W. Line

		0	

StaffordElev. 1836

Location

Rig up

Drilling and Remarks:

Vid 1037715" @ 37763000 sec/cPump 122 Pst42° Sw

RECORD

Cased _____ in., _____ ft.

Sand _____

Gas _____

Oil _____

Total Depth 3287

PRODUCTION

1st 24 hrs. Nat. _____

1st 24 hrs. after shot _____

Gas _____ Cu. Ft.

Dry Hole _____

Abandoned _____

Date

APR 1 1 1945 19S. J. LEWIS

Scout