

DX 78-1- Stafford

KANSAS

Section 7 Township 24 Range 13W

Well No. #2 Henderson

Company Petroleum Inc.

NORTH

				0			

WEST

EAST


SOUTH

SEC. 7-	TWP. #24	R. 13W
------------	-------------	-----------

WELL NO. #2 Henderson FARM

COMPANY
Petroleum Inc.

CONTRACTOR
Garvey

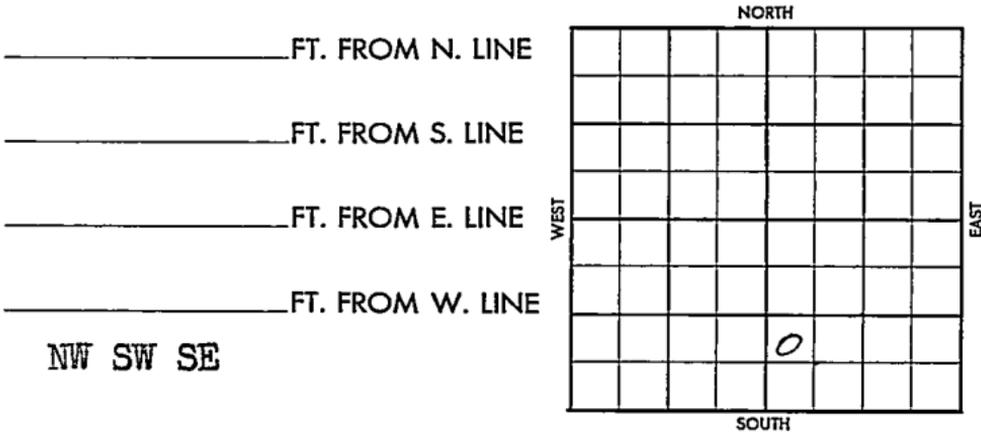

1956	ELEVATION 1926'	REPORT
------	--------------------	--------

7-18 MTR

8-29 Comm. 7-16-56
 8 5/8" @ 229 w/200
 DST 3632-55 op 1 hr., rec. 185' oily mdy SW, 1030/20".
 DST 3661-3710 op 1 hr., rec. 50' SOCM, BHP 200/20".
 DST 3712-50 op 1 hr. rec. 31' SGCM, BHP 1140#.
 DST 3774-3880 op 1 hr., gas in 8 min. rec. 160' O&GCM / 280' HOCCM / 120' mdy oil, 1100/20".
 DST 3845-3903 op 18 min. gas in 2 min. ga 3.880 MCF in 5 min. ga. 5 mill. in 10", rec. 120' GCM, 1520/20".
 DST 3882-92 op 10 min. gas in 2 min. ~~gas~~ ga. 13 mill. CF, rec. 5' GCM, BHP 1490/30"
 DST 3903-97 op 1 hr., gas in 49 min. rec. 45' mud, BHP 1350/30".
 5 1/2" @ 3960 w/100
 CO 3925
 Pf 3880-84; ga 9.205 MCF / 3/4" chk; 3 hrs.; CP 760#; TP 375#; M. 3880'
 KPL op dlw; 7.326 MCF; CP 701#
 H. 3409'; Tr. 3431'; Dg. 3448'; BL3544';
 L. 3571'; M. 3886'; K. 3979'; V. 3990';
 S. 4105'; A. 4161'; TD 4193

COMPLETED

County Stafford Elev. _____
 Sec. 7 Twp. 24 Rge. 13W
 Company Petroleum Inc.
 FarmName Henderson No. 2

TOPS	DEPTH	LOG	DATUM	Loc. in Sec.
Anh.				NW SW SE
TP.				
H.				
Tr.				
Dg.				
Bl.				
L.				Geol. _____
K.C.				Contr. _____
B.K.C.				<u>Garvey</u>
Ce.				Pool _____
C.				
M.				
M.				
K.				
Mz.				
Mo.				
V.				
S.				
S.				
A.				
R.				
PE.				
G.				
T.B.				

FIRST REPORT

Date Comm. M I R JUL 18 '56

0001 C 5 106

5 9

Co.
Lse.
No.
Sec.
T.
R.

County Stafford Elev. 1926Sec. 7 Twp. 21 Rgs. 707Company Petroleum Inc.Farm Name Johnerson No. 2

TOPS	DEPTH	LOG	DATUM	Loc. in Sec.
Anh.				
Tr.				
H.	3409			
Tr.	3431			
Dg.	3448			
Bl.	3544			
L.	3574			
K.C.				Geol.
B.K.C.				Contr.
Ce.				
C.				<u>Sandy</u>
M.	3886	3880		<u>Rattlesnake E</u>
M.				<u>Pool</u>
K.	3979			
Mz.				
Mo.				
V.	3990			COMPLETE
S.	4105			
S.				
A.	4161			
R.				
Pe.				
G.				
T.D.	4193			

Date Comm.

AUG 29 1956

I F JUL 25 '56 7-16-56 878 229
 1200 ϕ 3710 AUG 1 '56 DST 3632-55
 see 1 hr rec 185' oily Mdy SW
 1030/20" DST 3661-3710 1 hr
 see 50' 50 CM BHP 200/20"
 DST 3712-50 1 hr see 31' 56 CM
 BHP 1140 DST 3774-3880 1 hr
~~see~~ 9/8" see 160' 0 & 6 CM +
 280' 40 CM + 120' Mdy oil 1100/20"

DST 3845-3903 18" 9/2"

ga 3,880 MCF in 5" ga

5 Mill. in 10" rec 120' GCM

1520/20" DST 3882-92 up 10"

Double PKR 9/2" ga 13 Mill.

CF rec 5' GCM BHP 1490/30"

DST 3903-97 up 1 hr 9/40"

rec 45' Md BHP 1350/30"

5/2 @ 3960/100 AUG 8 '56

AUG 15 '56 CO 3925 PF 3880-84

ga 9,205 MCF 3/4" ch 3 hrs

CP 760# TP 375# AUG 22 '56

KPL up Flw 7,326 MCF

CP 701# AUG 29 '56

~~total for Miss.~~