


Section 7 Township 24 Range 11W

Well No. 1 Suiter

Company Natural Gas & Oil & Okla. Explor.

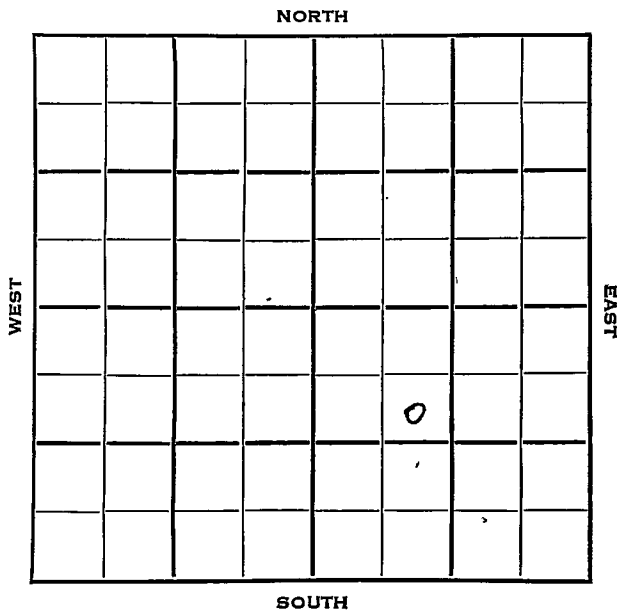

Stafford

KANSAS

SEC. 7	TWP. 24	R. 14W
-----------	------------	-----------


WELL NO. #1 Suiter FARM

COMPANY Natural Gas & Oil & Okla. Explor.

CONTRACTOR Co. Tools

Wildcat.

990 Ft. from N. Line
 _____ Ft. from S. Line
 _____ Ft. from E. Line
 990 Ft. from W. Line

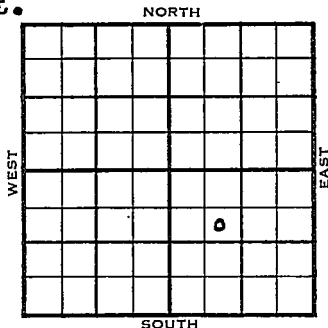

SE NW SE

1953	ELEVATION 1987'	REPORT
------	--------------------	--------

12/22 Spud 12-20-53
 8" @ 207'
 WOC

1954
 1/6 Drlg 4221'

1/13 Spud 12-20-53
 D&A
 TD 4265'
 8" @ 207'
 Anhy 934', Heeb 3532', Br line 3673',
 Lans 3684', B KC 3932', Cong 4037'
 DST 4079-4104', opn 1 hr., rec. 40'
 mud, 1320#
 Viola 4116', Simp 4188', Brb 4235'
 TD 4265'
 D&A

ABANDONED

