


Section 7 Township 24 Range 33W

Well No. #1 Shrimplin

Company Stanolind Oil and Gas Company

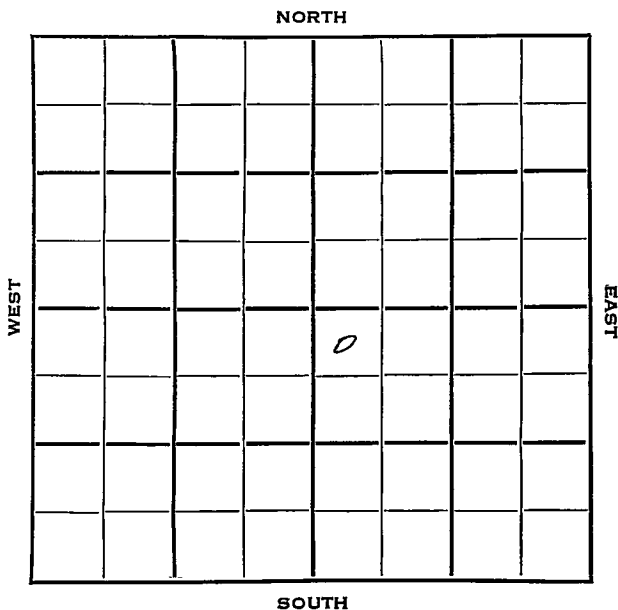

Finney

KANSAS ✓

Sec. 7 Twp. 24 R. 33 W

Well No. # 1 Shrimplin Farm

Stanolind Company

Contractor


150 Ft. from N. Line

Ft. from S. Line

Ft. from E. Line

150 Ft. from W. Line

NW SE

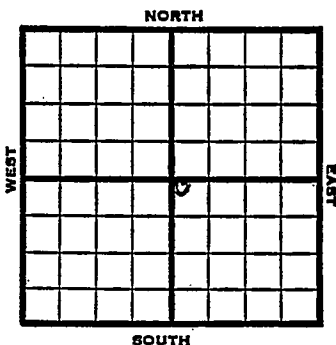

1953 Elev. 2882' REPORT

3/25 Location
 4/2 8" @ 847
 Her Kr 2512, Win 2578, Up Ft 2639,
 TD 2650
 5" @ 2639'

4/9 CO 2650, 1000A
 ,2521-26, 78/2527-40, 30/2543-48,
 48/2578-86, 78/2591-2604, 36/2614-20
 17,500A

4/15 Spud 3-24-53
 Gas Well
 TD 2650
 8" @ 847'
 Her. 2512, Win 2578, Ft. Riley 2639,
 TD 2650'
 5" @ 2639
 CO to 2650
 1000A Perf/ 2521-26 78/ 2527-40
 30/ 2543-48, 48/ 2578-86 78/ 2591-
 2604 36/ 2614-20 17500 A
 Comp. 4,274,000 gas

COMPLETED

