


KANSAS Finney

Section 7 Township 24 Range 34-W

Well No. #1 Ingram

Company Stanolind
Hugoton Pool

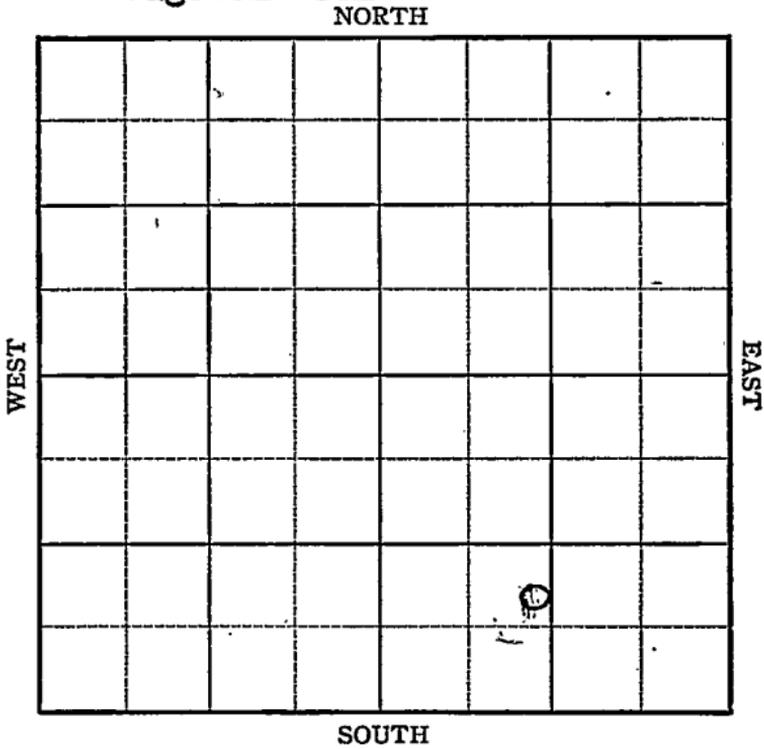

Sec. 7 Twp. 24 R. 34W ✓

Well No. 1 Ingram Farm

Stanolind Company


Hugoton Pool

_____ Ft. from N. Line

900 Ft. from S. Line

_____ Ft. from E. Line

1000 Ft. from W. Line

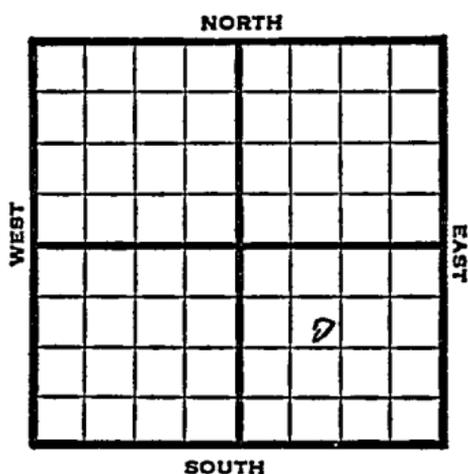

SE NW SE

1949

Elev 2923'

REPORT

8/24

Location

8/31

10" @ 814'

Drig 2501'

9/7

TD 2650'

7" @ 2623'

9/14

"

9/21

424 shots 241B-2594 - 3000 acid

9/28

28000 acid

10/5

"

10/12

TD 2650'

7" @ 2623'

Perf 31000 acid

2,929,000 Gas

415# R Pr.

Gomp

COMPLETED

Map No. _____ Sec. 7 Twp. 24 R. 34W

Well No. 1 Ingram

Stanolind Company

Contractor

SE NW SE

FIRST REPORT
SECTION PLAT

_____ Ft. from N. Line

900 Ft. from S. Line

_____ Ft. from E. Line

1000 Ft. from W. Line

Finney County

Location X

Rig up _____

Drilling and Remarks: _____

RECORD

Cased _____ in., _____ ft.

Sand _____

Gas _____

Oil _____

Total Depth _____

PRODUCTION

1st 24 hrs. Nat. _____

1st 24 hrs. after shot _____

Gas _____ Cu. Ft.

Dry Hole _____

Abandoned _____

Date

AUG 24 1949

S. J. LEWIS Scout

Map No. _____ Sec. 7 Twp. 24 R. 34W

Well No. 1 Ingram

Stanolind Company

COMPLETE Contractor

SE NW SE

E 12923
SECTION PLAT

_____ Ft. from N. Line

900 Ft. from S. Line

_____ Ft. from E. Line

1000 Ft. from W. Line

		0	

Finney County

RECORD

Location _____

Cased _____ in., _____ ft.

Rig up _____

Sand _____

Drilling and Remarks:

Gas _____

Oil _____

Total Depth 2650

PRODUCTION

1st 24 hrs. Nat. _____

1st 24 hrs. after shot _____

Gas _____ Cu. Ft.

Dry Hole _____

Abandoned _____

7' 12623
Perf
81000 acid
2,929,000 Gas

H 15 R 1/2

Date

OCT 12 1949 19

S. J. LEWIS Scout