

Section 8 Township 24 Range 4WWell No. #1 HeflingCompany J. H. Johnson

Burrtton Pool

NORTH

					0		

WEST

EAST

SOUTH

Reno **KANSAS** ✓

Sec. 8 Twp. 24 R. 4W

Well No. #1 Hefling Farm

J. H. Johnson

Burrton Pool


(Don Ingling, Contr.) Company

 Ft. from N. Line

330' Ft. from S. Line

 Ft. from E. Line

990' Ft. from W. Line

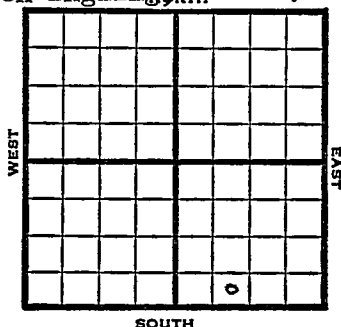

SE SW SE

1949

Elev. 1473' REPORT

12/21 8" @ 317'
Drlg. 2630'
12/28 Drlg 3050'
3/1 8" @ 317'
5" @ 3314'
Miss 3300'
7 BOPD
TD 3420'

COMPLETED

Map No. _____ Sec. 8 Twp. 24 R. 4W

Well No. 1 Hefling

J. H. Johnson Company

Don Ingling Contractor

SE SW SE

FIRST REPORT
SECTION PLAT

_____ Ft. from N. Line

330 Ft. from S. Line

_____ Ft. from E. Line

990 Ft. from W. Line

Reno County

Location _____

Rig up _____

Drilling and Remarks:

8" @ 317

drlg. 2630

RECORD

Cased _____ in., _____ ft.

Sand _____

Gas _____

Oil _____

Total Depth _____

PRODUCTION

1st 24 hrs. Nat. _____

1st 24 hrs. after shot _____

Gas _____ Cu. Ft.

Dry Hole _____

Abandoned _____

Date

DEC 21 194 19

S. I. LEWIS Scout

