
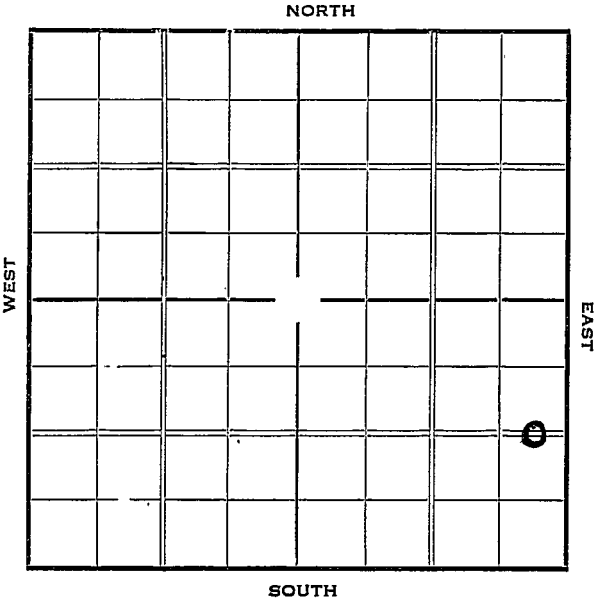


Section 8 Township 24 Range 4-W

Well Number #3 Showalter

Company Sinclair Prairie

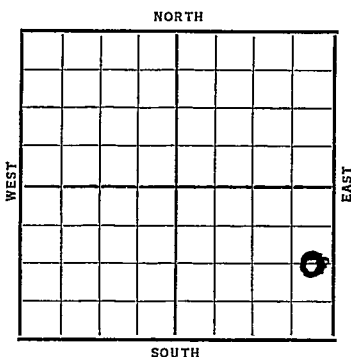

Sec. 8 Twp. 24 R. 4-WWell No. #3 Showalter FarmSinclair-Prairie Company Ft. from N. Line1320 Ft. from S. Line330 Ft. from E. Line Ft. from W. Line

Date	REPORT
1937	
6/30	Cellar
7/9	16" @ 408'.
7/16	Dr1g. 2185'.
7/23	Chat 3294'. T.D. 3305'.
	Rng. 8".
7/30	Chat 3298' (Corrected) T.D. 3375'.
	8" @ 3305'.
8/6	Swabbing 25 bbls. per day.
8/13	7000 acid.
8/18	8" @ 3305'.
	Chat 3298' (Corrected)
	T.D. 3375'.
	7000 acid.
	Flowed 74½ oil & 14 water in
	4 hours.
	Pot. 446 bbls.
	COMPLETED

Reno KANSAS

Map No. _____ Sec. 8 Twp. 24 R. 4 WWell No. 3-ShowalterSinclair Prairie Company

Contractor _____

FIRST REPORT

SECTION PLAT

_____ Ft. from N. Line

1320 Ft. from S. Line330 Ft. from E. Line

_____ Ft. from W. Line

			0

Location _____

Rig up _____

Drilling and Remarks:

Cellar

RECORD

Cased _____ in., _____ ft.

Sand _____

Gas _____

Oil _____

Total Depth _____

PRODUCTION

1st 24 hrs. Nat. _____

1st 24 hrs. after shot _____

Gas _____ Cu. Ft.

Dry Hole _____

Abandoned _____

Date

JUN 30 1937

19

H. D. Hatfield

Scout

Reno KANSAS

Map No. 40 Sec. 8 Twp. 24 R. 4WWell No. 3-ShawalterSimclair Company

Contractor

COMPLETED

SECTION PLAT

_____ Ft. from N. Line

1320 Ft. from S. Line330 Ft. from E. Line

_____ Ft. from W. Line

Location _____

Rig up _____

Drilling and Remarks:

7000 acidflowed 74 1/4 oil14 waterPot - 446

RECORD

Cased 8 in. 3305 ft.Sand Chat 3298Gas (Corrected)

Oil _____

Total Depth 3375

PRODUCTION

1st 24 hrs. Nat. _____

1st 24 hrs. after shot _____

Gas _____ Cu. Ft.

Dry Hole _____

Abandoned _____

Date

AUG 18 1937 19

H. D. Hatfield Scout