


Section 8 Township 24 Range 5W
Well No. #1 Bontrager
Company Monsanto & Rupp-Ferguson

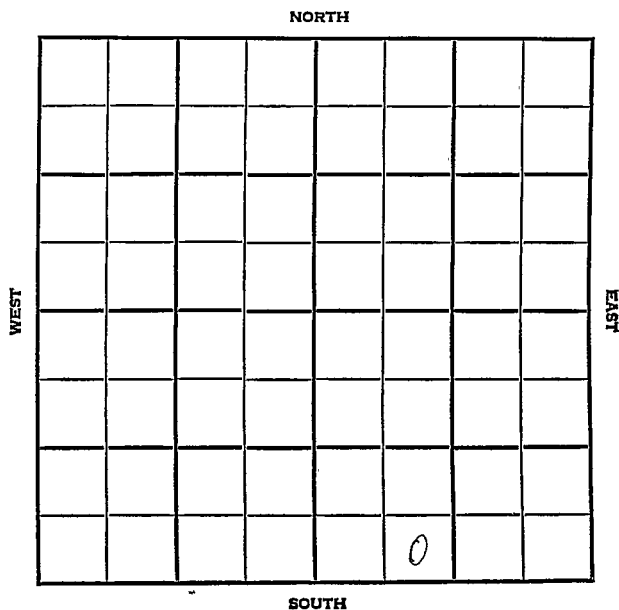

WILDCAT

FORM 513 SUNRAY

County Reno Elev. _____
 Sec. 8 Twp. 24 Rge. 5W
 Company Monsanto & Rupp-Ferguson
 Farm Name Bontrager No. 1

TOPS	DEPTH	LOG	DATUM
------	-------	-----	-------

Anh.			
Tr.			
H.			
Tr.			
Dg.			
BL.			
L.			
K.C.			
B.K.C.			
Ce.			
C.			
M.			
M.			
K.			
Mz.			
Mo.			
V.			
S.			
S.			
A.			
R.			
PE.			
G.			
T.D.			

Loc. in Sec. _____

SE SW SE

Geol. _____

Contr. _____

Rupp-Ferguson

Pool _____

Wildcat

FIRST REPORT

Oct. 31, '56

0

Date Comm. _____

Location _____

220' S 100'

100' S 100'

Co.

F

No.

Sec.

T.

R.

County Reno Elev. 1553 Co. 1
 Sec. 8 Twp. 24 Rge. 5W
 Company Monsanto & Rupp-Ferguson
 Farm Name Bontrager No. 1

TOPS	DEPTH	LOG	DATUM	Loc. in Sec.
Anb.				SE SW SE
Tp.				
H.	2606	2604		
Tr.				
Dg.				
Bl.	2782			
L.	2805	2790		
K.C.				Geol.
B.K.C.				Contr.
Ce.				Rupp-Ferguson
C.				Pool
M.	3460	3461		Wildcat
M.				
K.	3658	3660		
Mz. <u>chata</u>		3809		
Mo. <u>Mz.</u>		3843		
V.	3893	3892		
S.	3916	3917		
S.				
A.		4003		
R.				
PE.				
G.				
TD.	4050			

NOV 29 '56
 ABANDONED

Date Comm.

Location NOV 7 '56 11-3-56 13" @

245/225 ID 1365 NOV 13 '56

DST 3463-75 hr 1 hr 65' SW

FP 0-800 BHP 840/20" @ 3538

NOV 21 '56 ✓ NOV 28 '56

DST 3915-20

1 hr. 85' SW DHP 1050/20"

D & A