

Reno


KANSAS

FORM 51 5M 4-41 PETROL

Section 8 Township 24 Range 10-W

Well No. #1 Anderson Est.

Company Hall & Keesler

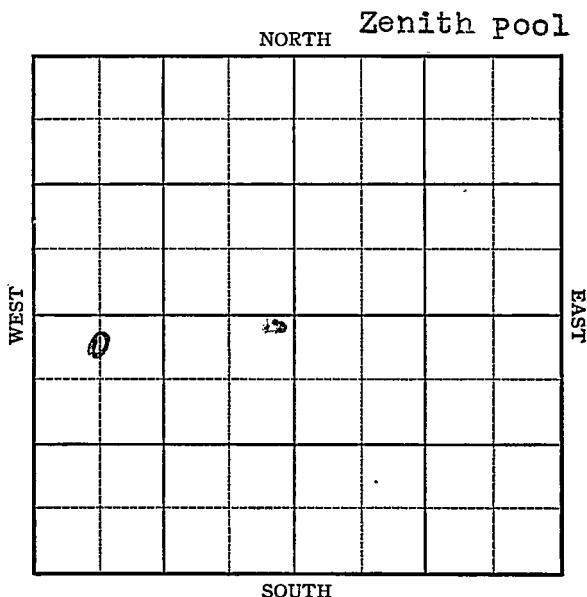

KANSAS


Reno

Sec. 8 Twp. 24 R. 10-WWell No. #1 Anderson Est. FarmHall & Keesler Company

(Zenith)

330 Ft. from N. Line Ft. from S. Line Ft. from E. Line660 Ft. from W. Line

Elev. 1793

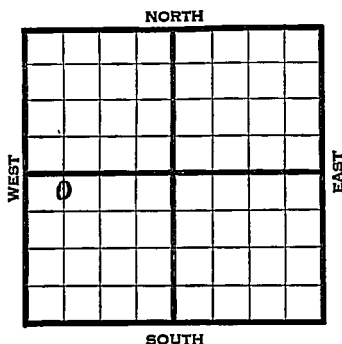

1941

REPORT

10/15

Location

10/23

"

10/30

"

11/6

"

11/13

"

11/20

10" - 259' WOC.

11/28

Anhy 480' Drlg. 2330'

12/4

Drlg. 3681'

12/10

Viola 3888'

T.D. 3910'

No shows.

ABANDONED

KANSAS

Map No. H-47 Sec. 8 Twp. 24 R. 10WWell No. 1 Anderson Est.Hall & Keesler CompanyFIRST REPORT Contractor

C NL NW SV

SECTION PLAT

330 Ft. from N. Line Ft. from S. Line Ft. from E. Line660 Ft. from W. Line

o			

ZENITH POOL

Location XXRig up Drilling and Remarks:

RECORD

Cased in., ft.Sand Gas Oil Total Depth

PRODUCTION

1st 24 hrs. Nat. 1st 24 hrs. after shot Gas Cu. Ft.Dry Hole Abandoned

Date

OCT 15 1941

19

S. J. LEWIS Scout

Reno

KANSAS

Map No. 47 Sec. 8 Twp. 24 R. 10WWell No. 1. Anderson Est.Hall & Kessler CompanyABANDONED Contractor

SECTION PLAT

o			

C NL NW SW

330 Ft. from N. Line Ft. from S. Line Ft. from E. Line660 Ft. from W. Line

ZENITH POOL

Location Rig up

Drilling and Remarks:

*Vid 3888**Noe house*

RECORD

Cased in., ft.Sand Gas Oil Total Depth 3910

PRODUCTION

1st 24 hrs. Nat. 1st 24 hrs. after shot Gas Cu. Ft.Dry Hole Abandoned

Date

DEC 10 1941

19

S. J. LEWIS Scout