

KANSAS


Stafford

FORM 51 5M BR1X

Section 8 Township 24 Range 11W

Well No. #1, Waples

Company Gulf Oil

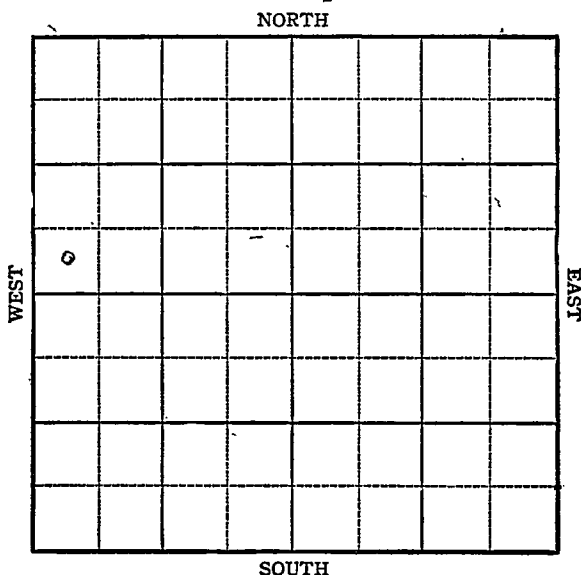

KANSAS

Stafford

Sec. 8 Twp. 24 R. 11W

Well No. #1, Waples Farm

Gulf Company


Ranson

 Ft. from N. Line

330 Ft. from S. Line

 Ft. from E. Line

330 Ft. from W. Line

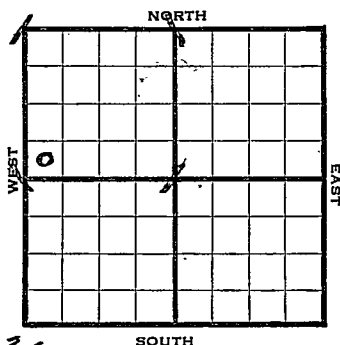

Elev. 1836

1944

REPORT

5/31

Location

6/7

8" @ 336 WOC

6/15

Drlg. 2760

6/21

Drlg. 3687

6/28

Viola 3788

5" @ 3790

TD 3794

3000 oil in 12 hrs

7/12

Viola 3788

5" @ 3790

1000 Acid

Bomt Pot 5912

Max. 3000

Gravity 41.0

TD 3794

COMPLETED

Pool Name Ranson**KANSAS**Map No. 47 Sec. 8 Twp. 24 R. 11WWell No. 1 WaplesGulf

Company

FIRST REPORT

Contractor

SW NW

SECTION PLAT

Ft. from N. Line

330

Ft. from S. Line

Ft. from E. Line

330

Ft. from W. Line

Stafford CountyLocation X

Rig up

Drilling and Remarks:

RECORD

Cased _____ in., _____ ft.

Sand _____

Gas _____

Oil _____

Total Depth _____

PRODUCTION

1st 24 hrs. Nat. _____

1st 24 hrs. after shot _____

Gas _____ Cu. Ft.

Dry Hole _____

Abandoned _____

Date

MAY 3 1 1944 19S. J. LEWIS Scout

Pool Name RansonMap No. 47 KANSAS Sec. 8 Twp. 24 R. 11WWell No. 1 WaplesGulf

Company

COMPLETED

Contractor

SW NW

SECTION PLAT

6			

_____ Ft. from N. Line

330 Ft. from S. Line

_____ Ft. from E. Line

330 Ft. from W. LineStafford County

Location _____

Rig up _____

Drilling and Remarks:

*Viola 3788**5" C 3790**1000 cu ft**Bam & P 2859/2**May 3000**41° N*

RECORD

Cased _____ in., _____ ft.

Sand _____

Gas _____

Oil _____

Total Depth 3784

PRODUCTION

1st 24 hrs. Nat. _____

1st 24 hrs. after shot _____

Gas _____ Cu. Ft.

Dry Hole _____

Abandoned _____

Date

JUL 12 1944 19S. J. LEWIS

Scout