


Section 8 Township 24 Range 11W
Well No. #1 Waples
Company Wm. Graham

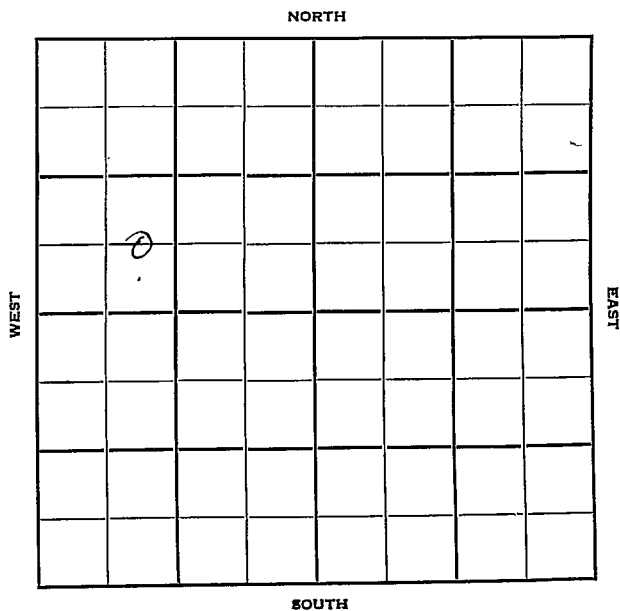

Sec. 8 Twp. 24 R. 11W

Well No. #1 Waples Farm

Wm. Graham Company

Contractor


Zenith Pool

 Ft. from N. Line

660
990' Ft. from S. Line

 Ft. from E. Line

990' Ft. from W. Line

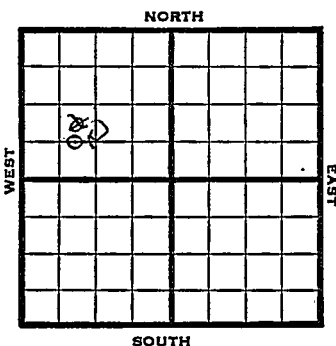

~~NE SW NW~~

C E L SW NW

1950 E lev 1834' REPORT

3/1 RUR

3/22 8"@ 173'
Anhy 624-37'
Viola 3778'
5"@ 3779'
TD 3792'
Bail 7 BW 1 gal oil pd
D&A
Aband.

ABANDONED

Kansas

Zenith Pool

Map No. _____ Sec. 8 Twp. 24 R. 11WWell No. 1 WaplesWm. Graham

Company

Contractor

NE SW NW

SECTION PLAT

o			

FIRST REPORT

_____ Ft. from N. Line

990 Ft. from S. Line

_____ Ft. from E. Line

990 Ft. from W. LineStafford County

Location _____

Rig up _____

Drilling and Remarks:

R U R

RECORD

Cased _____ in., _____ ft.

Sand _____

Gas _____

Oil _____

Total Depth _____

PRODUCTION

1st 24 hrs. Nat. _____

1st 24 hrs. after shot _____

Gas _____ Cu. Ft.

Dry Hole _____

Abandoned _____

Date

MAR 1 1950

19

J. E. TYRA

Scout


Map No. _____ Sec. 8 Twp. 24 R. 11WWell No. 1 WaplesWm. Graham Company

CORRECTION

Contractor

C E L SW NW

SECTION PLAT

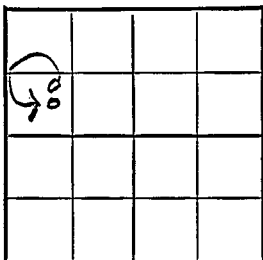 Ft. from N. Line660 Ft. from S. Line Ft. from E. Line990 Ft. from W. LineStafford County

Location _____

Rig up _____

Drilling and Remarks:

Reported

NE SW NW

RECORD

Cased _____ in., _____ ft.

Sand _____

Gas _____

Oil _____

Total Depth _____

PRODUCTION

1st 24 hrs. Nat. _____

1st 24 hrs. after shot _____

Gas _____ Cu. Ft.

Dry Hole _____

Abandoned _____

Date

MAR 8 1950

J. E. TYR ^ Scout

Map No. _____ Sec. 8 Twp. 24 R. 11WWell No. 1 WaplesWm. Graham


Company

Contractor

C E L SW NW

E-1. 1834

SECTION PLAT

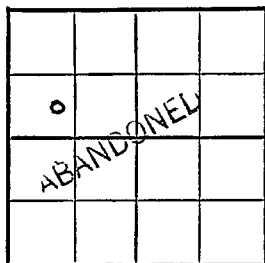

Ft. from N. Line

660

Ft. from S. Line

Ft. from E. Line

990

Ft. from W. Line

Stafford County

Location _____

Rig up _____

Drilling and Remarks:

8" C 173

anhy 624-37

Viola 3778

5" C 3779

T.D 3792

Bail 7bw 1 gal oil
pd

D+A

RECORD

Cased _____ in., _____ ft.

Sand _____

Gas _____

Oil _____

Total Depth _____

PRODUCTION

1st 24 hrs. Nat. _____

1st 24 hrs. after shot _____

Gas _____

Cu. Ft.

Dry Hole _____

Abandoned _____

Date

MAR 22 1950

19

J. E. TYRA

Scout