


Section 8 Township 24 Range 11W

Well No. #3 Figger

Company Plains Exploration

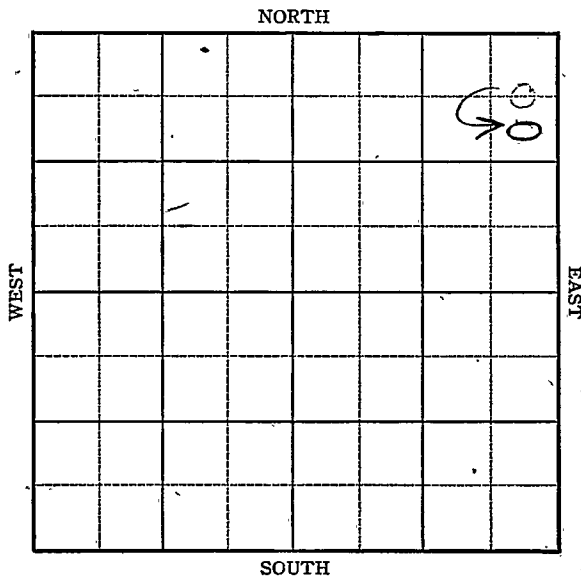

KANSAS Stafford County

Sec. 8 Twp. 24 R. 11W

Well No. #3 Figger Farm

Plains Exploration Company

Ranson


NORTH

~~660~~ ⁹⁹⁰ Ft. from N. Line

_____ Ft. from S. Line

330 Ft. from E. Line

_____ Ft. from W. Line

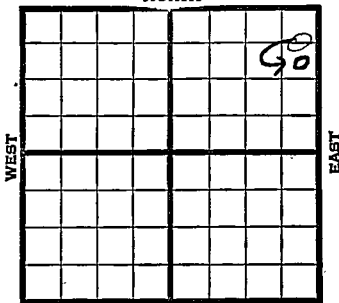

SOUTH

~~SE NE NE~~ *1824*

1945

REPORT

3/28	8" @ 183 Drlg. 1135
4/5	Anhy 570 Drilling 29158
4/12	Lans 3466 Viola 3765 TD 3769 Run csg.
4/20	5" @ 3767' RUST
4/27	TD 3776 2500 acid. Flow 10 oil plus 5 wtr. PH
5/3	" " " " " " "
5/10	" " " " " " "
5/17	" " " " " " "
5/24	" " " " " " "
5/29	Viola 3765 5" @ 3767 TD 3776 2500 acid. Pump 643 Pot. Grav. 40.9

COMPLETED

Pool Name RansonMap No. K47 Sec. 8 Twp. 24 R. 11WWell No. 3 FiggerPlains Exploration

Company

CORRECTION

Contractor

SE NE NE

SECTION PLAT

990 Ft. from N. Line

_____ Ft. from S. Line

330 Ft. from E. Line

_____ Ft. from W. Line

			o

Stafford

Location _____

Rig up _____

Drilling and Remarks:

reported

C E L NE NE

RECORD

Cased _____ in., _____ ft.

Sand _____

Gas _____

Oil _____

Total Depth _____

PRODUCTION

1st 24 hrs. Nat. _____

1st 24 hrs. after shot _____

Gas _____ Cu. Ft.

Dry Hole _____

Abandoned _____

Date

APR 4 1945

19

S. J. LEWIS

Scout

Kansas Pool Name Ranson

Map No. 47 Sec. 8 Twp. 24 R. 11W

Well No. 3 Figger

Plains Exploration Company

COMPLETED Contractor

SE NE NE

SECTION PLAT

990 Ft. from N. Line

_____ Ft. from S. Line

330 Ft. from E. Line

_____ Ft. from W. Line

			o

Stafford County

Location _____

Rig up _____

Drilling and Remarks:

*Vista 3765.
5' @ 3767
2500 acw
Pump 643 P.D.
40' Gr.*

RECORD

Cased _____ in., _____ ft.

Sand _____

Gas _____

Oil _____

Total Depth 3776

PRODUCTION

1st 24 hrs. Nat. _____

1st 24 hrs. after shot. _____

Gas _____ Cu. Ft.

Dry Hole _____

Abandoned _____

Date

MAY 29 1945

S. I. LEWIS Scout