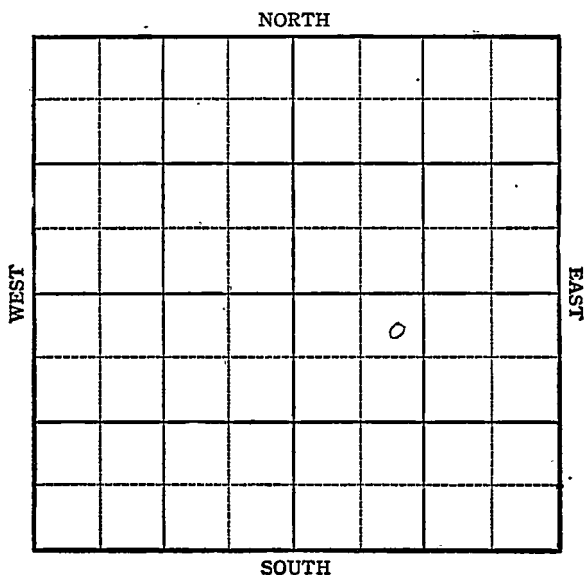


KANSAS

Stafford

Section 8 Township 24 Range 11WWell No. #1 KellyCompany Transwestern

KANSAS

Sec. 8 Twp. 24 R. 11W

Well No. #1, Kelly Farm

Transwestern Company

Ranson


NORTH

330 Ft. from N. Line

Ft. from S. Line

Ft. from E. Line

990 Ft. from W. Line

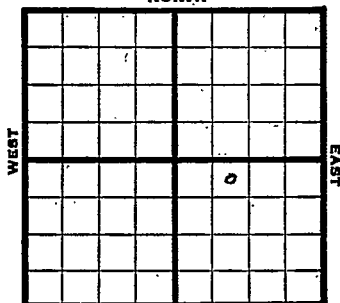

Elev. 1825

1944

REPORT

6/14	Retary
6/21	Drlg. 1900
6/28	Drlg. 3082
7/12	Viola 3787
	5" @ 3789
	TD 3790 RUST
7/19	TD 8797 SO&W
7/26	TD 3808-1500 acid swb. 11 oil plus 19 wtr. in 12 hrs.
8/2	" " " " " " " " "
8/9	" " " " " " " " "
8/16	2000 acid 3802-065 fsg.
8/23	Viola 3787
	5" @ 3789
	5500 acid
	TD 3808
	Wtr.

ABANDONED

Pool Name Ranson**KANSAS**Map No. 7 / 7 Sec. 8 Twp. 24 R. 11WWell No. 1 KellyTranswestern

Company

FIRST REPORT

Contractor

NE NW SE

SECTION PLAT330


Ft. from N. Line

Ft. from S. Line

Ft. from E. Line

990

Ft. from W. Line

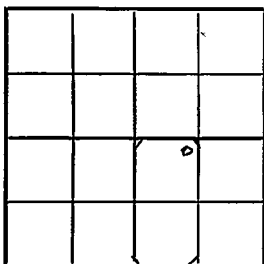**Stafford County**

Location _____

Rig up _____

Drilling and Remarks:

Rotary**RECORD**

Cased _____ in., _____ ft.

Sand _____

Gas _____

Oil _____

Total Depth _____

PRODUCTION

1st 24 hrs. Nat. _____

1st 24 hrs. after shot _____

Gas _____ Cu. Ft.

Dry Hole _____

Abandoned _____

Date

JUN 1 4 1944

19

S. J. LEWIS

Scout

Pool Name Zenith WestMap No. 47 Sec. 8 Twp. 24 R. 11WWell No. 1 KellyTranswestern Company**ABANDONED**

Contractor

NE NW SE

SECTION PLAT

		6	

330 Ft. from N. Line Ft. from S. Line Ft. from E. Line990 Ft. from W. LineStafford CountyLocation Rig up

Drilling and Remarks:

Viola 378?
5" casing
5500 cu ft
Water

RECORDCased in., ft.Sand Gas Oil Total Depth 3808**PRODUCTION**1st 24 hrs. Nat. 1st 24 hrs. after shot Gas Cu. Ft.Dry Hole Abandoned

Date

AUG 23 1944 19S. J. LEWIS Scout