

Stafford

KANSAS

Section 8 Township 24 Range 12WWell No. #1 Knoche "A"Company C R A

NORTH

							0

WEST

EAST

SOUTH

Sec. 8 Twp. 24 R. 12W

Well No. #1 Knoche "A" Farm

C R A Company

Contractor


Wildcat
330' Ft. from N. Line

Ft. from S. Line

330' Ft. from E. Line

Ft. from W. Line

NE NE NE

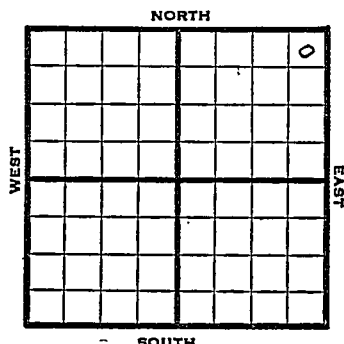

1950

Elev 1881'

REPORT

12/6

Spud 12-4-50
8" @ 235'

1951
2/14

Spud 12-4-50
Gas Well TD 4037'
8" @ 235' Heeb. 3290'
Br Lime 3438' Lans. 3463'
DST 3475-3516 opn $\frac{1}{2}$ hr
Rec. 35' gcm DST 3636-85 opn $\frac{1}{2}$ hr
Rec. 34' socm Cong. 3780'
Viola 3809'
DST 3811-19 opn 15 min F/ $3\frac{1}{2}$ mcf g
60' gcm
DST 3819-39 opn $\frac{1}{2}$ hr
Est. $\frac{1}{4}$ Mefg 120' gcm Simp 3947'
Arb. 4007-37 TD $5\frac{1}{2}$ " @ 4023'
136/3850-86 $\frac{1}{2}$ go 15 hr. SP 3840
48/3810-21 Gomp. 2,300,000 gas

COMPLETES



Operator **C R A**

Well No. 1 Farm Knoche "A"

Elev. 1881 Location NE NE NE

330 Ft. From N Line NE

330 Ft. From E Line Quarter

1st. Report DEC. 6 1950

Completion

Remarks CSO & Sinclair DEM

Spudding Date 12-4-50

Drig. Data Wildcat

8th @ 235

County Stafford State Kansas
 Sec. 8 (Blk.) 2 4 (Sur.) 12W Map No.
 Operator C R A
 Well No. 1 Farm Knoche "A"
 Elev. 1881 Location NE NE NE

330 Ft. From N Line NE
330 Ft. From E Line Quarter
 1st. Report FEB 14 1951
 Completion
 Remarks Wildcat
 Spudding Date 12-4-50

Drlg. Data Gas well TD 4037
8" @ 235 Heeb. 3290 Br. lime 3438
Lans. 3463 DST 3476-3516 open $\frac{1}{2}$ hr.
Rec. 35' gcm DST 3636-85 open $\frac{1}{4}$ hr.
Rec. 34' socm 'Cong. 3780 Viola 3809
DST 3811-19 open 15 min. F/ $3\frac{1}{2}$ mcf/g
60' gcm DST 3819-39 open $\frac{1}{2}$ hr.
Est. $\frac{1}{4}$ mcf/g 120' gcm Simp. 3947
Arb. 4007-37 TD $5\frac{1}{2}$ " @ 4023 136/ 3850-86
 $\frac{1}{2}$ go 15 hr. SP 3840 48/ 3810-21
Comp. 2,300,000 gas

J. E. TYRA