
Stafford

KANSAS

SECTION 8 TOWNSHIP 24S RANGE 12W

WELL NO. #1 ~~Connaughbay~~ Jordan

COMPANY Osage O&G

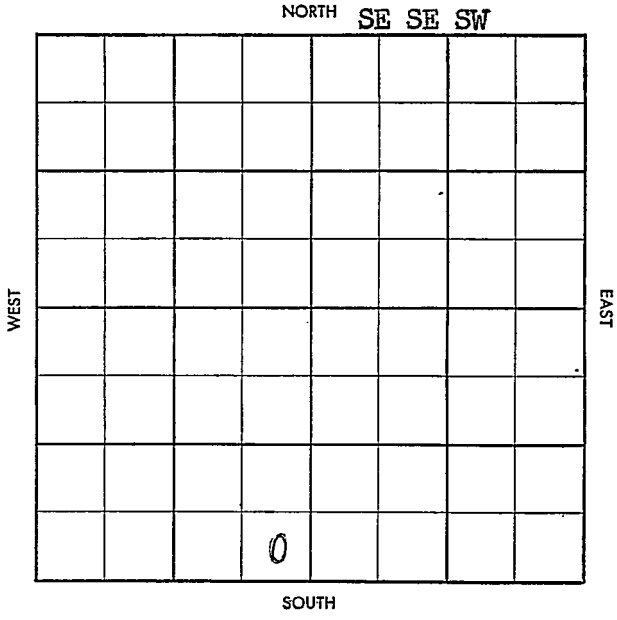

FORM 504-3 SUNRAY

Twp. Pool

Co. Facet

WILDCAT

S–513–B

County Stafford Elev.

Sec. 8 Twp. 24 Rge. 12W

Company Osage O & G

Farm Name Connaughbay No. 1


TOPS	DEPTH	LOG	DATUM
Anh.			
Tp.			
H.			
Tr.			
Dg.			
B.L.			
L.			
K.C.			
B.K.C.			
Ce.			
C.			
M.			
M.			
K.			
Mz.			
Mq.			
V.			
S.			
S.			
A.			
R.			
Pf.			
G.			
T.D.			

Loc. in Sec. SE SE SW

Geol.

Contr. Rex & Morris


Pool Wildcat

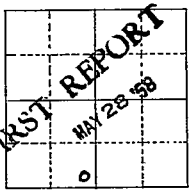

Date Comm.

MI

Co. Lse #1 No. Sec. T. R.

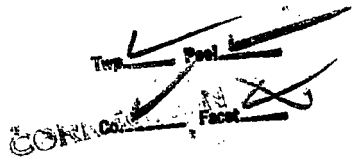

S-513-B

County Stafford Elev. 1888DF 1891KB Co.

Sec. 8 Twp. 24 Rge. 12W

Company Osage O & G

Farm Name Connaughbay Jordan No. 1

TOPS	DEPTH	LOG	DATUM
Anh.			
Tp.			
H.	3326		
Tr.			
Dg.			
B.L.			
L.	3505		
K.C.			
B.K.C.			
Ce.			
C.			
M.			
M.			
K.			
Mz.			
Mq.			
V.	3871		
Sl.			
S.			
A.			
R.			
Pf.			
G.			
T.D.	3876		

Loc. in Sec. SE SE SW

Geol.

Contr. Rex & Morris

Pool konchy

Wildcat

COMPLETE

AUG 27 '58

Lse. No.

Date Comm. 5-29-58 8" 392

MI JUN 3 '58 # 3465 JUN 11 '58 DST 3870

-7.6 1hr g/12" 750' gsy sh

+20' mco 30' ocm FP 4d-210

BHP 1020/15 -1005/30" no log

5½" 3871 f75 CO 3876 FU

1000' oil 1hr NW pop JUN 18 '58

JUN 25 '58 JUL 2 '58 JUL 9 '58 JUL 16 '58 P50

Boyd NW mat JUL 23 '58 JUL 30 '58

AUG 6 '58 AUG 13 '58 AUG 20 '58 AUG 27 '58

P169 BO + 5% Wtr 41.2°

Sec. T. R.