


Section 8 Township 24 Range 12W

Well No. #1 O'Connor

Company Eldorado

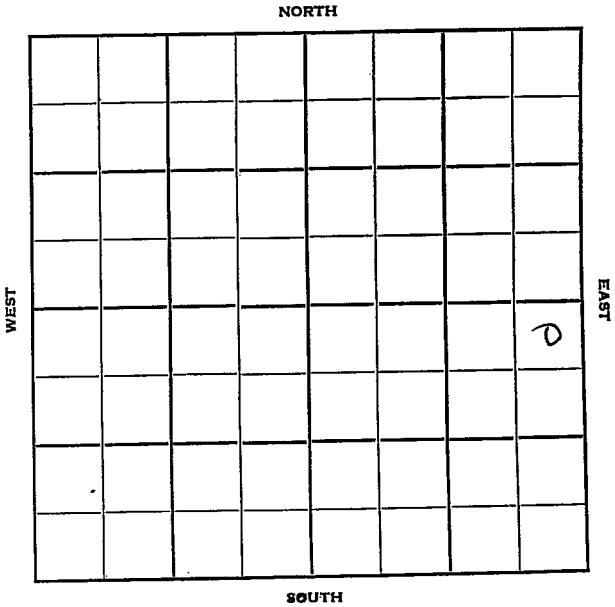

Stafford

KANSAS

Sec. 8 Twp. 24 R. 12 W ✓

Well No. # 1 O'Conner Farm

El Dorado Company

Sterling Contractor

Semi-Wildcat


330 Ft. from N. Line

 Ft. from S. Line

330 Ft. from E. Line

 Ft. from W. Line

NE NE SE

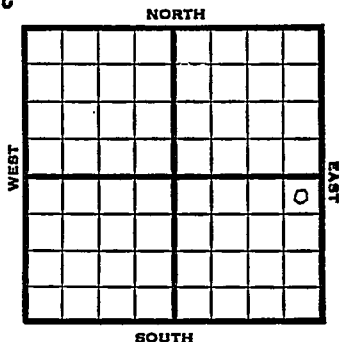

1951

Elev. 1886' REPORT

6/13

Location

8/1

Spd 6-25-51

D&A TD 3914

8" @ 264

Heeb. 3313 Br lime 3463

Lans. 3493 Cong. 3803

Viola 3850

DST 3851-67 opn 45 min.

Rec. 200,000 gas 100' ocm

TD 3914 5" @ 3914

CO to 3895

16/3889-93 16/3878-82 500 A

S/10 go 7 bwph PB 3884

70/3857-67 1000 A wtr.

D&A

ABANDONED

County Stafford State KansasSec. 8 (Blk.) 24 (Sur.) 12W Map No.Operator El DoradoWell No. 1 Farm O'ConnorElev. Location NE NE SE

FIRST REPORT

330 Ft. From W Line SE330 Ft. From E Line Quarter1st. Report JUN 13 1951

Completion

Remarks


Sterling - Contr.

Spudding Date

Drlg. Data

Location Semi Wildcat

J. E. TYRA

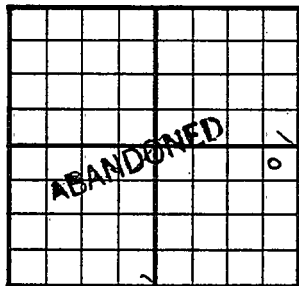County Stafford State KansasSec. 8 (Blk.
Twp.) 24 (Sur.
Rge.) 12W Map No.Operator Eldorado Ref.Well No. 1 Farm O'ConnerElev. 1886 Location NE NE SE330 Ft. From N Line SE330 Ft. From E Line Quarter

1st. Report

Completion AUG 1 1951Remarks Semi WildcatSterling Drlg. - Contr.Spudding Date 6-25-51Drlg. Data D & A TD 39148" @ 264 Heeb. 3313 Br. lime 3463Lans. 3493 Cong. 3803 Viola 3850DST 3851-67 open 45 min. Rec. 200,000 gas100' ocm TD ^{NE}3914 5" @ 3914 CO to 389516/ 3889-93 16/ 3878-82 500 AS/ 10 go 7 bwph PB 3884 70/ 3857-671000 A waterD & A

J. E. TYRA