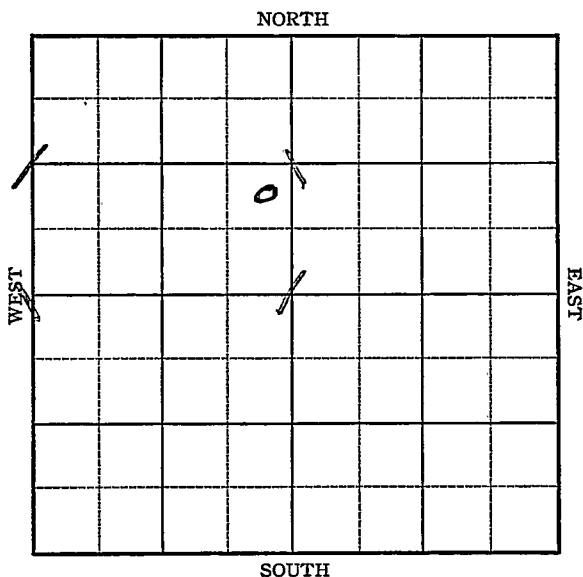



KANSAS

Stafford

Section 8 Township 24 Range 13-WWell No. #1 McConnaughbayCompany Torrey & Feaster et al

Sec. 8 Twp. 24 R. 13-WWell No. #1 McConnaughbay FarmTorrey & Feaster et al Company Ft. from N. Line990 Ft. from S. Line330 Ft. from E. Line Ft. from W. Line

Elev. 1923

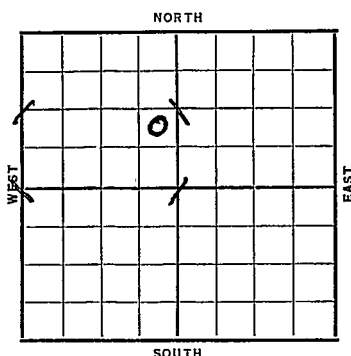

Date

REPORT

~~1937~~

10/20

R. R.

10/29

R. U. R.

11/5

13" @ 158'. Anhy 665'.

Drlg. 2052'.

11/12

Drlg. 3139'.

11/19

K.C. 3595'. Drlg. 3945'.

No shows Rep.

11/26

Viola 4020'. Simp. 4075'.

T.D. 4145'. No shows. SDO.

12/1

Sil. 4130'.


T.D. 4155'.

Sulphur water.

ABANDONED

Stafford **KANSAS**Map No. 83 Sec. 8 Twp. 24 R. 13WWell No. 1 McConnaughayTorrey & Feaster et al Company

Contractor

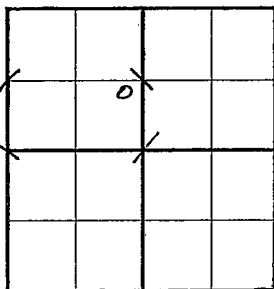FIRST REPORT
NE SE NW**SECTION PLAT** Ft. from N. Line990 Ft. from S. Line330 Ft. from E. Line Ft. from W. LineLocation Rig up

Drilling and Remarks:

RR**RECORD**Cased in., ft.Sand Gas Oil Total Depth **PRODUCTION**1st 24 hrs. Nat. 1st 24 hrs. after shot Gas Cu. Ft.Dry Hole Abandoned

Date

 OCT 20 1937 H. D. Hatfield Scout

Stafford **KANSAS**Map No. 83 Sec. 8 Twp. 24 R. 13WWell No. 1 McConnaughayTorrey & Feaster et al Company

Contractor

ABANDONED**NE SE NW** Ft. from N. Line990 Ft. from S. Line330 Ft. from E. Line Ft. from W. Line**SECTION PLAT**

	0		

Location Rig up

Drilling and Remarks:

Sulphur waterD & A**RECORD**Cased in., ft.Sand 511 4130Gas Oil Total Depth 4155**PRODUCTION**1st 24 hrs. Nat. 1st 24 hrs. after shot Gas Cu. Ft.Dry Hole Abandoned

Date

DEC 1 - 1937

19

H. D. Hatfield

Scout