

Section 8 Township 24 Range 13WWell No. #1 GarnerCompany Westgate-Greenland

NORTH

WEST

EAST

							0

SOUTH

Stafford KANSAS

Sec. 8 Twp. 24 R. 13W

Well No. #1 Garner Farm

Westgate-Greenland

Company

W-G

Wildcat

Contractor

 Ft. from N. Line

330


Ft. from S. Line

330

Ft. from E. Line

 Ft. from W. Line

SE SE SE

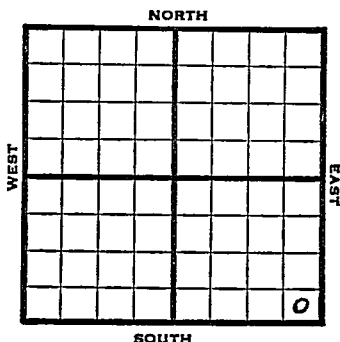

1953

Elev. 1925'

REPORT

4/29

MIR

5/7

Drlg. 3400

5/13

Spud 4-28-53 D & A TD 4153'
Anhy 815' Heeb 3400 Br line 3542'
Lans. 3568 B KC 3827 Viola 3922
Simp. 4047 Simp sd 4075
DST 4076-87 open 1 hr. rec 15' mud Off
Arb. 4113' TD 4153'
D & A

ABANDONED

County **Stafford** State **Kansas**

Sec. 8 (Blk. Twp.) 24 (Sur. Rge.) 13W Map No.

Operator **Westgate-Greenland**

Well No. **1** Form **Garner**

Elev.	Location	SE	SE	SE
-------	----------	----	----	----

FIRST REPORT

330 Ft. From S Line SE

330 Ft. From E Line Quarter

1st. Report APR 29 1953

Completion

Remarks

Spudding Date _____

Drig. Data Wildcat

M I R

County Stafford State KansasSec. 8 (Blk. Twp.) 24 (Sur. Rge.) 13W Map No.Operator Westgate-GreenlandWell No. 1 Farm GarnerElev. 1925 Location SE SE SE330 Ft. From S Line SE330 Ft. From E Line Quarter

1st. Report

Completion MAY 13 1953Remarks WildcatW-G - Contr.Spudding Date 4-28-53Drig. Data D & A TD 4153Anhy 815 Heeb. 3400 Br. lime 3542Lans. 3568 B KC 3827 Viola 3922Simp. 4047 Simp. sd. 4075 DST 4076-87open 1 hr. Rec. 15' mud 0# Arb. 4113TD 4153D & A

J. G. McGEHEE