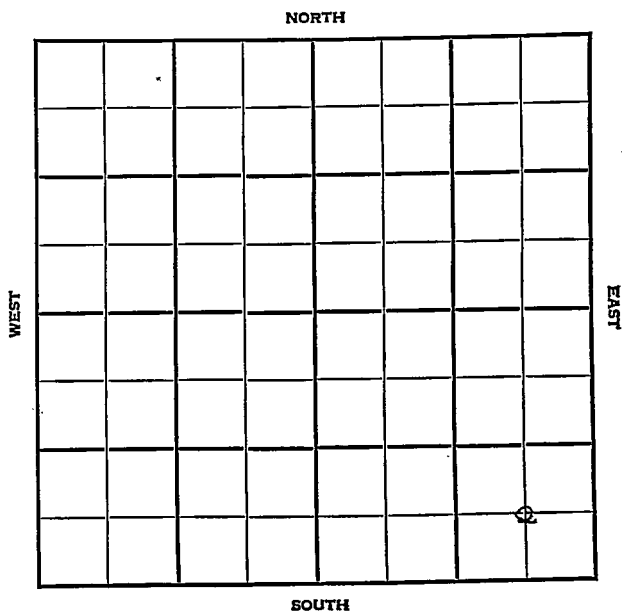


Section 8 Township 24 Range 15-WWell No. #1 O'Conner "B"Company Cities Service

KANSAS

Stafford

Sec. 8 Twp. 24 R. 15WWell No. #1 O'Connor "B" Farm


Cities Service

Maxwell Pool

Company

 Ft. from N. Line660' Ft. from S. Line660' Ft. from E. Line Ft. from W. Line

C SE SE

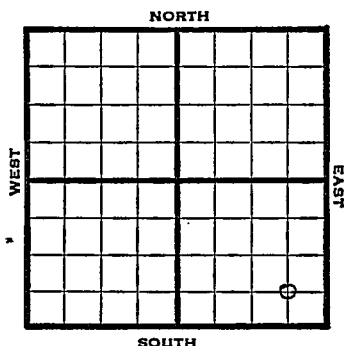

1948

Eli 2034'

REPORT

6/16 Location
 6/23 8"@ 398'
 Drlg 1520
 6/29 D lg 3375'
 7/8 Lansing 3650'
 Drlg 3785'
 7/14 Viola 4055'
 Simpson 4175'
 Arb. 4118'
 TD 4160'
 5"@ 3892'
 12 shots 3808-19 W
 12 shots 3768-79
 Plug 3795'
 7/21 1000 acid
 Pump 27 bbls oil / 45 W 24 hrs.
 7/28 Pump 37 bbls oil / 59 W 22 hrs.
 8/4 "
 8/11 "
 8/18 "
 8/25 Lansing 3650'
 Arb. 4118'
 TD 3160'
 5"@ 3892'
 Perf 7 ans 3500 acid
 Pump 54 Oil / 122 W Pot
 290 Gr.
 Comp

COMPLETED


Map No. _____ Sec. 8 Twp. 24 R. 15WWell No. 1 O'Conner "B"

_____ Cities Service _____ Company

FIRST REPORT _____ Contractor

C SE SE

SECTION PLAT

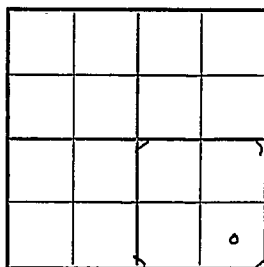

_____ Ft. from N. Line

660 Ft. from S. Line660 Ft. from E. Line

_____ Ft. from W. Line

Stafford CountyLocation X

Rig up _____

Drilling and Remarks:

RECORD

Cased _____ in., _____ ft.

Sand _____

Gas _____

Oil _____

Total Depth _____

PRODUCTION

1st 24 hrs. Nat. _____

1st 24 hrs. after shot _____

Gas _____ Cu. Ft.

Dry Hole _____

Abandoned _____

Date

JUN 16 1948 19 S. I. LEWIS Scout

Stafford County Kansas State

Map No. 83 Sec. 8 Twp. 24 R. 15W

Well No. 1 O'Conner "B"

Cities Service Company

COMPLETE Contractor

C SE SE


E. 1.2034
SECTION PLAT

 Ft. from N. Line

660 Ft. from S. Line

660 Ft. from E. Line

 Ft. from W. Line

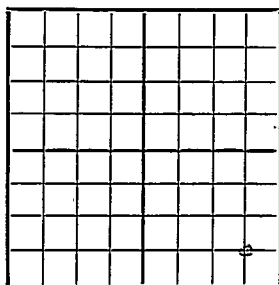

Maxwell Pool

Remarks:

Liana 3650

Cr 4118

723160

5" @ 3892

Perf 4000

35000000

Pump 5400lb + 122 WBT

29² lb

Date
AUG 25 1948

Scout S. J. LEWIS